

STATE ENGINEER
Salem, Oregon

UMAT
4700

Well Record

STATE WELL NO. 6N/35-26^{dcc}
COUNTY Umatilla
APPLICATION NO. GR-1413

GR- 1367

By Aaron Weis

OWNER: James A. Hughes


MAILING ADDRESS: Rt. 3, Box 329

LOCATION OF WELL: Owner's No. _____

CITY AND STATE: Milton-Freewater, Oregon

SW $\frac{1}{4}$ SE $\frac{1}{4}$ Sec. 26 T. 6 ~~S~~^N R. 35 ~~XX~~^E, W.M.

Bearing and distance from section or subdivision corner 620' E. & 75' N. from S $\frac{1}{4}$ cor. Sec. 26

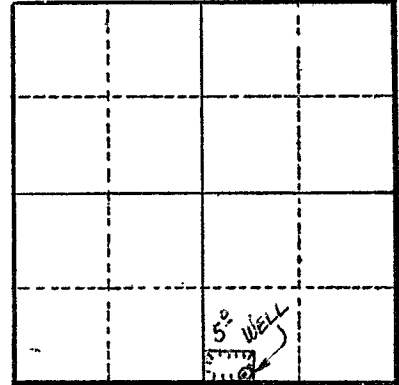

Section 26

Altitude at well 900'

TYPE OF WELL: Dug & Drill Date Constructed 1913

Depth drilled 70' Depth cased 57'

CASING RECORD:

Dug - 4' x 6' concrete from 0 to 16 ft.
Drilled- 4" steel from 49 to 57 ft.

FINISH:

AQUIFERS:

WATER LEVEL:

26'

PUMPING EQUIPMENT: Type DeLaval 2" H.P. 3

Capacity 150 G.P.M.

WELL TESTS:

Drawdown _____ ft. after _____ hours _____ G.P.M.

Drawdown _____ ft. after _____ hours _____ G.P.M.

USE OF WATER Irrigation Temp. _____ °F., 19 _____

SOURCE OF INFORMATION G. R. Record -1367

DRILLER or DIGGER _____

ADDITIONAL DATA:

Log N.A. Water Level Measurements _____ Chemical Analysis _____ Aquifer Test _____

REMARKS:

Irrigation of 5 acres.

*assignment sent 4-21-70 wsb
Drilled deeper 1968 to 108 feet see log*