

STATE ENGINEER
Salem, Oregon

UMAT
4701

Well Record

STATE WELL NO. 6N/35E-260
COUNTY UMATILLA
APPLICATION NO. GR-2330

OWNER: Norman Seibold


MAILING ADDRESS: Rt. 3, Box 58

LOCATION OF WELL: Owner's No.

CITY AND STATE: Milton-Freewater, Oregon

NW 1/4 NW 1/4 Sec. 26 T. 6 N. S. R. 35 E. W.M.

Bearing and distance from section or subdivision corner 620' E. and 680' N.

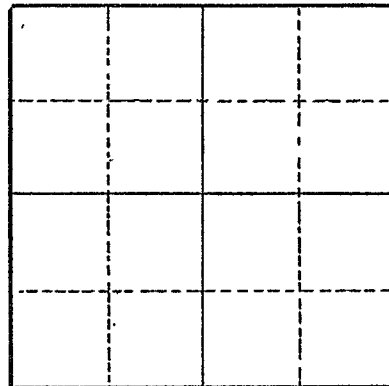

Section

Altitude at well

TYPE OF WELL: Dug & Drilled Constructed 1910

Depth drilled 60 Depth cased 25 & 60

CASING RECORD:

5-feet
12-inch

FINISH:

AQUIFERS:

WATER LEVEL:

20-feet

PUMPING EQUIPMENT: Type Berkeley Turbine H.P. 3
Capacity 300 G.P.M.

WELL TESTS:

Drawdown ? ft. after hours Pumping 300 G.P.M.
Drawdown ft. after hours G.P.M.

USE OF WATER Irrigation Temp. °F. 19

SOURCE OF INFORMATION GR-2216

DRILLER or DIGGER

ADDITIONAL DATA:

Log Water Level Measurements Chemical Analysis Aquifer Test

REMARKS: