

STATE ENGINEER  
Salem, Oregon

UMAT  
4702

# Well Record

GR- 1211


STATE WELL NO. 6N/35-260  
COUNTY Umatilla  
APPLICATION NO. GR- 1255

OWNER: Curtis M. & Blanche I. Snow MAILING ADDRESS: Rt. 3, Box 330

LOCATION OF WELL: Owner's No. \_\_\_\_\_ CITY AND STATE: Milton-Freewater, Oregon

SW 1/4 SE 1/4 Sec. 26 T. 6 N. XX, R. 26 XX, W.M.

Bearing and distance from section or subdivision corner 25' N. & 980' E. from S 1/4 cor. Sec. 26.

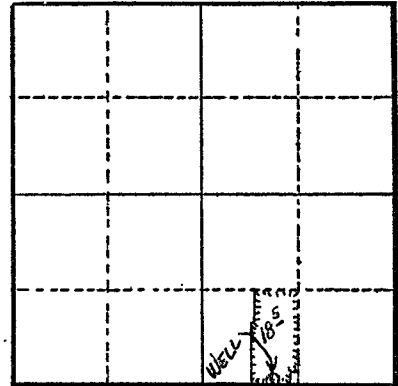

Section 26

Altitude at well 975 ft.

TYPE OF WELL: Dug&Drill'd Date Constructed 1910

Depth drilled 85 ft. Depth cased 85 ft.

### CASING RECORD:

4 x 4 ft. concrete curb from 0 to 14 ft.  
8 in. steel from 56 to 85 ft.

### FINISH:

### AQUIFERS:

### WATER LEVEL:

15 ft.

PUMPING EQUIPMENT: Type Jacuzzi 4 x 4 in. Cent. H.P. 5  
Capacity 450 G.P.M.

### WELL TESTS:

Drawdown \_\_\_\_\_ ft. after \_\_\_\_\_ hours \_\_\_\_\_ G.P.M.  
Drawdown \_\_\_\_\_ ft. after \_\_\_\_\_ hours \_\_\_\_\_ G.P.M.

USE OF WATER Irrigation Temp. \_\_\_\_\_ °F. \_\_\_\_\_, 19\_\_\_\_

SOURCE OF INFORMATION G. R. Record

DRILLER or DIGGER Bill Jones

### ADDITIONAL DATA:

Log N.A. Water Level Measurements \_\_\_\_\_ Chemical Analysis \_\_\_\_\_ Aquifer Test \_\_\_\_\_

### REMARKS:

Irrigation of 18.5 acres.