

STATE ENGINEER  
Salem, Oregon

UMAT  
4703

# Well Record

STATE WELL NO. 6N/35 - 26A  
COUNTY UMATILLA  
APPLICATION NO. GR-1966

OWNER: Claude E. Anderson


MAILING ADDRESS: Rt. 3, Box 229

LOCATION OF WELL: Owner's No. \_\_\_\_\_

CITY AND STATE: Milton-Freewater, Oregon

SE <sup>1</sup>/<sub>4</sub> of NE <sup>1</sup>/<sub>4</sub> NE <sup>1</sup>/<sub>4</sub> Sec. 26 T. 6 N. R. 35 E. W., W.M.

Bearing and distance from section or subdivision corner 400' W. & 910' S.

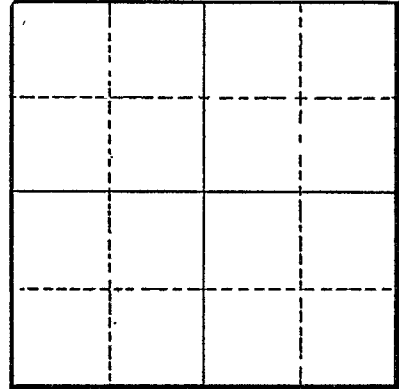

Section \_\_\_\_\_

Altitude at well \_\_\_\_\_

TYPE OF WELL: Dug & Drilled Date Constructed 1910

Depth drilled 54.4 Depth cased 18 - 30

### CASING RECORD:

6-inch  
8-inch

### FINISH:

### AQUIFERS:

No information

WATER LEVEL: 10-feet

PUMPING EQUIPMENT: Type Delaval Centrifugal H.P. 3  
Capacity 275 G.P.M.

WELL TESTS:  
Drawdown 10 ft. after \_\_\_\_\_ hours Pumping 275 G.P.M.  
Drawdown \_\_\_\_\_ ft. after \_\_\_\_\_ hours \_\_\_\_\_ G.P.M.

USE OF WATER Irrigation Temp. \_\_\_\_\_ °F. \_\_\_\_\_, 19

SOURCE OF INFORMATION GR-1894

DRILLER or DIGGER Deceased (Jim Overturft)

### ADDITIONAL DATA:

Log \_\_\_\_\_ Water Level Measurements \_\_\_\_\_ Chemical Analysis \_\_\_\_\_ Aquifer Test \_\_\_\_\_

### REMARKS: