

STATE ENGINEER  
Salem, Oregon

UMAT  
4704

# Well Record

STATE WELL NO. 6N/35-26B(1)  
COUNTY Umatilla  
APPLICATION NO. GR-1133

GR- 1093

OWNER: Andrew J. & Mabel Gilmore

MAILING

ADDRESS: Rt. 3, Box 215


LOCATION OF WELL: Owner's No.

CITY AND

STATE: Milton-Freewater, Oregon

N. E.  
NW ¼ NE ¼ Sec. 26 T. 6. R. 35, W.M.

Bearing and distance from section or subdivision  
corner 558' S. & 75' W. of NE cor. of NW ¼ NE ¼ of  
Section 26.

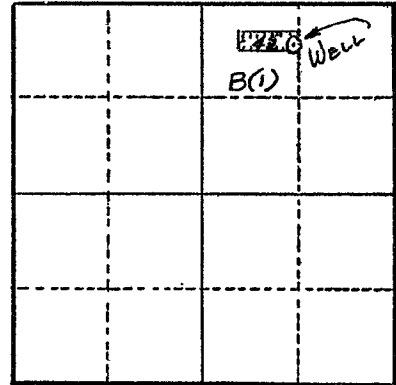

Section 26

Altitude at well 900 ft.

TYPE OF WELL: Dug Date Constructed 1909

Depth drilled 25 ft. Depth cased 12 ft.

### CASING RECORD:

5' x 5' concrete curb from 0 to 12 ft.

### FINISH:

### AQUIFERS:

### WATER LEVEL:

15 ft.

PUMPING EQUIPMENT: Type Pump, pipe & power 2½ in. H.P. 1½  
Capacity G.P.M.

### WELL TESTS:

Drawdown ft. after hours G.P.M.  
Drawdown ft. after hours G.P.M.

USE OF WATER Irrigation Temp. °F., 19

SOURCE OF INFORMATION G. R. Record

DRILLER or DIGGER

### ADDITIONAL DATA:

Log Water Level Measurements Chemical Analysis Aquifer Test

### REMARKS:

Log: Top soil & gravel 0 to 12 ft.  
Clay & gravel 12 to 25 ft.

Irrigation of 4½ acres.