

UMAT
4705

Well Record

STATE WELL NO. 6N/35-26A
COUNTY UMATILLA
APPLICATION NO. GR-1756

OWNER: Page M. Didion


MAILING ADDRESS: Rt 3 Box 219

LOCATION OF WELL: Owner's No.

CITY AND STATE: Milton-Freewater

NE 1/4 NE 1/4 Sec. 26 T. 6 N. R. 35 E., W.M.

Bearing and distance from section or subdivision corner 1335' N 1056' W of NE corner SE 1/4

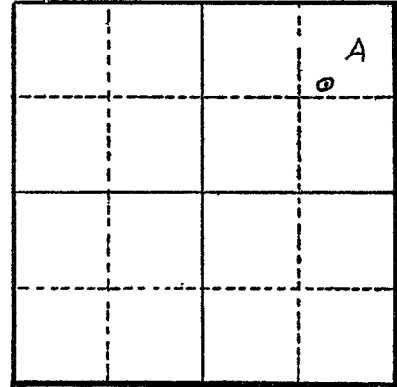

Altitude at well

TYPE OF WELL: Dug Date Constructed 1909

Depth drilled 40' Depth cased 15'

Section 26

CASING RECORD:

72 X 72 - inch

FINISH:

AQUIFERS:

Top soil, cemented gravel

WATER LEVEL:

14'

PUMPING EQUIPMENT: Type Centrifugal Pump

H.P. 3

Capacity 300 G.P.M.

WELL TESTS:

Drawdown 8 ft. after 300 hours G.P.M.

Drawdown ft. after hours G.P.M.

USE OF WATER Irrigation Temp. °F. 19

SOURCE OF INFORMATION GR-3887

DRILLER or DIGGER Jim Overturf (Deceased)

ADDITIONAL DATA:

Log NA Water Level Measurements Chemical Analysis Aquifer Test

REMARKS: