

UMAT  
4706


# Well Record

OWNER: John Wesley Bailey MAILING ADDRESS: Route 3,

LOCATION OF WELL: Owner's No. CITY AND STATE: Milton-Freewater, Oregon

SE 1/4 NW 1/4 Sec. 26 T. 6 N. R. 35 E. W., W.M.

Bearing and distance from section or subdivision corner 30' N. from 30' W. from SE Cor. Sec. 26

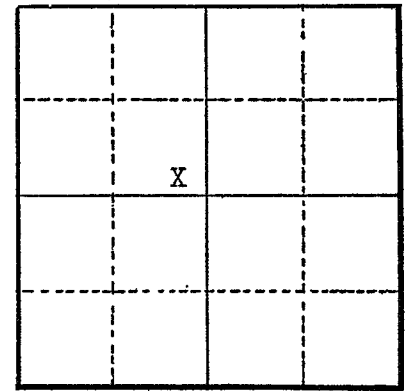

Section 26

Altitude at well \_\_\_\_\_

TYPE OF WELL: Drilled 50' Date Constructed \_\_\_\_\_  
Dug 30'

Depth drilled 80 feet Depth cased \_\_\_\_\_

### CASING RECORD:

8 inch casing depth is unknown

### FINISH:

### AQUIFERS:

### WATER LEVEL:

30 feet below surface

PUMPING EQUIPMENT: Type centrifugal 2 1/2" H.P. 5  
Capacity 400 G.P.M.

### WELL TESTS:

Drawdown \_\_\_\_\_ ft. after \_\_\_\_\_ hours \_\_\_\_\_ G.P.M.  
Drawdown \_\_\_\_\_ ft. after \_\_\_\_\_ hours \_\_\_\_\_ G.P.M.

USE OF WATER Irrigation Temp. \_\_\_\_\_ °F., 19  
SOURCE OF INFORMATION Well Registration Statement Cert. # GR-3509

### DRILLER or DIGGER

### ADDITIONAL DATA:

Log X Water Level Measurements \_\_\_\_\_ Chemical Analysis \_\_\_\_\_ Aquifer Test \_\_\_\_\_

### REMARKS:

Log: Gravel - to bottom of well except 2 feet top, gravelly soil.