

STATE ENGINEER  
Salem, Oregon

UMAT  
4728

# Well Record

STATE WELL NO. 6N/35-27  
COUNTY UMATILLA  
APPLICATION NO. GR-2562

OWNER: Chris Feigner & Carrie Feigner

MAILING ADDRESS: R F D 2, Box 346


LOCATION OF WELL: Owner's No. #3

CITY AND STATE: Milton-Freewater, Oregon

NW 1/4 SW 1/4 SE 1/4 Sec. 27 T. 6 N. S, R. 35 E. W.M.

Bearing and distance from section or subdivision

corner 650' S. & 650' E.

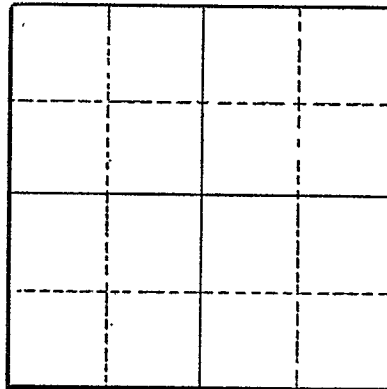

Section

Altitude at well

TYPE OF WELL: Dug, Drilled Date Constructed 1910

Depth drilled 100 Depth cased 53

### CASING RECORD:

8-inch  
60-inch

### FINISH:

### AQUIFERS:

Rock

### WATER LEVEL:

30-feet

PUMPING EQUIPMENT: Type Deming Turbine H.P. 5  
Capacity 325 G.P.M.

### WELL TESTS:

Drawdown 2 ft. after hours Pumping 325 G.P.M.

Drawdown ft. after hours G.P.M.

USE OF WATER Irrigation Temp. °F., 19

SOURCE OF INFORMATION GR-2420

DRILLER or DIGGER

### ADDITIONAL DATA:

Log  Water Level Measurements  Chemical Analysis  Aquifer Test

### REMARKS:

Concrete rock, brown	45	52
Water course	52	58
Concrete rock brown	58	80
Water course	80	83
Concrete rock brown	83	100