



# Well Record


STATE WELL NO. 6N/35-27N(2)  
COUNTY UMATILLA  
APPLICATION NO. U-4

OWNER: Mrs. C.B. Harris MAILING ADDRESS: \_\_\_\_\_

LOCATION OF WELL: Owner's No. \_\_\_\_\_ CITY AND STATE: Milton Oregon

SW 1/4 SW 1/4 Sec. 27 T. 6 N. 8, R. 35 E. W., W.M.

Bearing and distance from section or subdivision corner \_\_\_\_\_

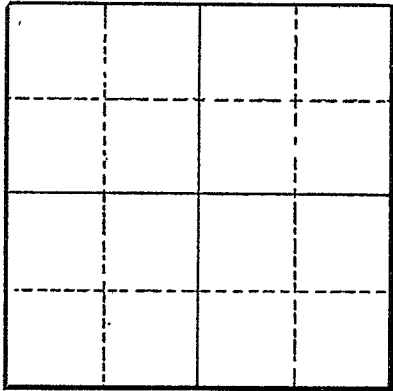

Altitude at well 865

TYPE OF WELL: Drilled Date Constructed \_\_\_\_\_

Depth drilled 114 Depth cased \_\_\_\_\_

Section 27

### CASING RECORD:

72-8 inch

### FINISH:

AQUIFERS: Gravel from 17 to 47  
from 110 to 114 ±

### WATER LEVEL:

17.17' (June 7, 1933)

PUMPING EQUIPMENT: Type Centrifugal H.P. \_\_\_\_\_  
Capacity 200 G.P.M.

### WELL TESTS:

Drawdown \_\_\_\_\_ ft. after \_\_\_\_\_ hours \_\_\_\_\_ G.P.M.  
Drawdown \_\_\_\_\_ ft. after \_\_\_\_\_ hours \_\_\_\_\_ G.P.M.

USE OF WATER Irr. 30 acs Temp. \_\_\_\_\_ °F. \_\_\_\_\_, 19\_\_\_\_

SOURCE OF INFORMATION \_\_\_\_\_

DRILLER or DIGGER \_\_\_\_\_

### ADDITIONAL DATA:

Log \_\_\_\_\_ Water Level Measurements \_\_\_\_\_ Chemical Analysis \_\_\_\_\_ Aquifer Test \_\_\_\_\_

### REMARKS:

Two drilled wells insid. dug well.