

STATE ENGINEER
Salem, Oregon

UMAT
4737

Well Record

GR- 1267

STATE WELL NO. 6N/35-27K(2)
COUNTY Umatilla
APPLICATION NO. GR- 1310

OWNER: Benny LaFore

MAILING

ADDRESS: Rt. 3, Box 304

LOCATION OF WELL: Owner's No. _____


CITY AND

STATE: Milton-Freewater, Oregon

N. E.
NW ¼ SE ¼ Sec. 27 T. 6 S. R. 35 W., W.M.

Bearing and distance from section or subdivision

corner 640' E. & 825' S. from NW cor. of NW ¼ SE ¼
or the Center of Sec. 27.

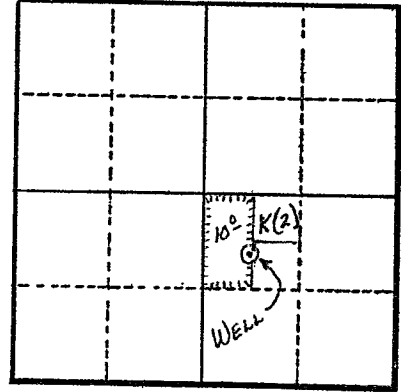

Section 27

Altitude at well 850 ft.

TYPE OF WELL: Dug Date Constructed 1922

Depth drilled 34 ft. Depth cased 12 ft.

CASING RECORD:

72 x 72 in. concrete curb from 0 to 12 ft.

FINISH:

AQUIFERS:

WATER LEVEL:

23 ft.

PUMPING EQUIPMENT: Type 3 in. Cent. H.P. 5
Capacity 125 G.P.M.

WELL TESTS:

Drawdown 2 ft. after _____ hours 125 G.P.M.

Drawdown _____ ft. after _____ hours _____ G.P.M.

USE OF WATER Irrigation Temp. _____ °F. _____, 19

SOURCE OF INFORMATION G. R. Record

DRILLER or DIGGER _____

ADDITIONAL DATA:

Log _____ Water Level Measurements _____ Chemical Analysis _____ Aquifer Test _____

REMARKS:

Log: Top soil (gravel) 0 to 3 ft.
Cemented gravel & cobbles 3 to 34 ft.

Irrigation of 10 acres.