

STATE ENGINEER  
Salem, Oregon

UMAT  
4738

# Well Record

STATE WELL NO. 6N/35-27L  
COUNTY Umatilla  
APPLICATION NO. GR-1824

GR- 1739

OWNER: Herbert J. Fox

MAILING  
ADDRESS:


LOCATION OF WELL: Owner's No.

CITY AND  
STATE:

Milton-Freewater, Oregon

NE 1/4 SW 1/4 Sec. 27 T. 6 N. R. 35 E. W.M.

Bearing and distance from section or subdivision  
corner 60' W. & 80' N. from SE cor. of NE 1/4 of  
SW 1/4 of Sec. 27.

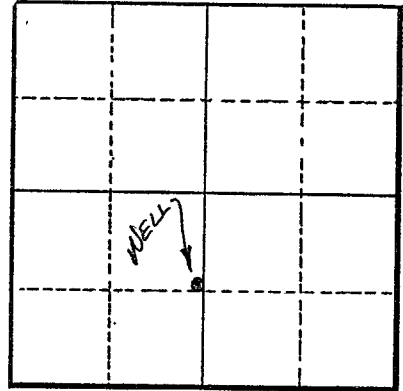

Section 27

Altitude at well 750'

TYPE OF WELL: Dug & Drill'd Date Constructed 1920-Prior to

Depth drilled 70' Depth cased 70'

### CASING RECORD:

6' x 6' concrete curb from 0 to 16 ft.  
5 1/2" steel casing from 40 to 70 ft.

### FINISH:

### AQUIFERS:

### WATER LEVEL:

30'

PUMPING EQUIPMENT: Type Worthington 4" Cent. H.P. 5  
Capacity 400 G.P.M.

### WELL TESTS:

Drawdown 4 ft. after 400 G.P.M.  
Drawdown ft. after hours G.P.M.

USE OF WATER Irrigation Temp. °F. 19

SOURCE OF INFORMATION GR Record

DRILLER or DIGGER

### ADDITIONAL DATA:

Log Water Level Measurements Chemical Analysis Aquifer Test

### REMARKS:

Log: Top soil 0 to 3 ft.  
Gravel 3 to 40 ft.  
Gravel 40 to 70 ft.

Irrigation of 15 acres.