

UMAT
4739

Well Record


STATE WELL NO. 6N/35-27L
COUNTY Umatilla
APPLICATION NO. GR-3488

OWNER: Martin Dee Irelund MAILING ADDRESS: Box 1004

LOCATION OF WELL: Owner's No. _____ CITY AND STATE: Milton-Freewater, Oregon

NE 1/4 SW 1/4 Sec. 27 T. 6 N. 35 E. W., W.M.

Bearing and distance from section or subdivision corner 825' E. and 518' S.

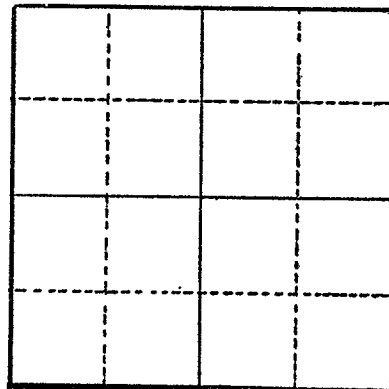

Section _____

Altitude at well _____

TYPE OF WELL: dug Date Constructed 1919

Depth drilled 30' Depth cased 16'

CASING RECORD:

72"

FINISH:

AQUIFERS:

WATER LEVEL:

20'7"

PUMPING EQUIPMENT: Type Delco-Centrifugal 3" H.P. 3
Capacity 250 G.P.M.

WELL TESTS:

Drawdown _____ ft. after _____ hours _____ G.P.M.

Drawdown _____ ft. after _____ hours _____ G.P.M.

USE OF WATER Irrigation Temp. _____ °F. _____, 19_____

SOURCE OF INFORMATION GR-3219

DRILLER or DIGGER W. C. Hopsow

ADDITIONAL DATA:

Log _____ Water Level Measurements _____ Chemical Analysis _____ Aquifer Test _____

REMARKS: