

STATE ENGINEER  
Salem, Oregon

UMAT  
4741

# Well Record

STATE WELL NO. 6N/35-27P(2)  
COUNTY Umatilla  
APPLICATION NO. GR-1167

GR- 1128

OWNER: Bartha E. Bline

MAILING  
ADDRESS:

LOCATION OF WELL: Owner's No.


CITY AND  
STATE:

Milton-Freewater, Oregon

SE ¼ SW ¼ Sec. 27 T. 6 N. 3, R. 35 W., W.M.

Bearing and distance from section or subdivision

corner 35' W. & 40' N. from SE cor. of SE ¼ SW ¼ of  
Section 27.

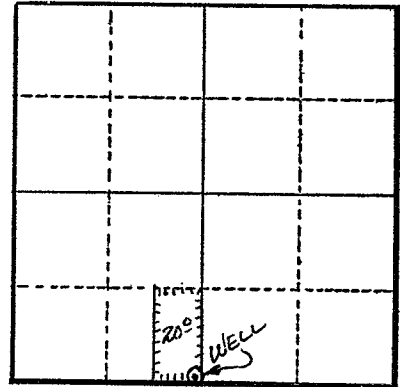

Section 27

Altitude at well 830 ft.

TYPE OF WELL: Dug&Drilled Date Constructed 1918

Depth drilled 152 ft. Depth cased 75 ft.

### CASING RECORD:

12 inch from 55 to 75 ft.

Dug for 55 ft. ( 6 x 6 ft.)

Drilled for 97 ft.

### FINISH:

2 - 6 x ½ in. perforations from 55 to 75 ft.

### AQUIFERS:

### WATER LEVEL:

30 ft.

PUMPING EQUIPMENT: Type Western turbine H.P. 15  
Capacity 550 G.P.M.

### WELL TESTS:

Drawdown 150 ft. after \_\_\_\_\_ hours 425 (August) G.P.M.

Drawdown \_\_\_\_\_ ft. after \_\_\_\_\_ hours \_\_\_\_\_ G.P.M.

USE OF WATER Irrigation Temp. \_\_\_\_\_ °F. \_\_\_\_\_, 19\_\_\_\_

SOURCE OF INFORMATION G. R. Record

DRILLER or DIGGER Charles Yeager

### ADDITIONAL DATA:

Log N.A. Water Level Measurements \_\_\_\_\_ Chemical Analysis \_\_\_\_\_ Aquifer Test \_\_\_\_\_

### REMARKS:

Irrigation of 20 acres.