

STATE ENGINEER
Salem, Oregon

UMAT
4742

Well Record

STATE WELL NO. 6N/35-27K
COUNTY Umatilla
APPLICATION NO. GR-4070

OWNER: Aaron & Kathryn LeFore


MAILING ADDRESS: Route 3, Box 304

LOCATION OF WELL: Owner's No. _____

CITY AND STATE: Milton-Freewater, Oregon

NW 1/4 SE 1/4 Sec. 27 T. 6 N. 35 E. W.M.

Bearing and distance from section or subdivision
corner 1340' N. & 650' E. of S¹/₄ Cor. Sec. 27

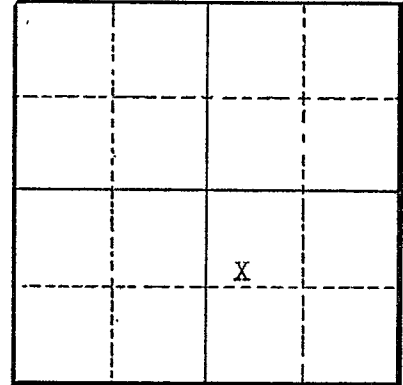

Section 27

Altitude at well _____

TYPE OF WELL: Dug 39' Drill 22' Date Constructed 1915

Depth drilled 61 ft. Depth cased _____

CASING RECORD:

72 in. concrete from 0 to 15 ft.
6 inch steel casing from 38' to unknown depth

FINISH:

AQUIFERS:

WATER LEVEL:

20 feet below surface

PUMPING EQUIPMENT: Type centrifugal coop 5" H.P. 5
Capacity 275 G.P.M.

WELL TESTS:

Drawdown _____ ft. after _____ hours _____ G.P.M.
Drawdown _____ ft. after _____ hours _____ G.P.M.

USE OF WATER Irrigation Temp. _____ °F., 19 _____

SOURCE OF INFORMATION Well Registration Statement Cert. # GR-3667

DRILLER or DIGGER _____

ADDITIONAL DATA:

Log _____ Water Level Measurements _____ Chemical Analysis _____ Aquifer Test _____

REMARKS: