

STATE ENGINEER  
Salem, Oregon

UMAT  
4743

# Well Record

GR- 1199

STATE WELL NO. 6N/35-27P(1)  
COUNTY Umatilla  
APPLICATION NO. GR- 1241

OWNER: L. R. Edwards

MAILING

ADDRESS: Rt. 3, Box 189

LOCATION OF WELL: Owner's No.


CITY AND

STATE: Milton-Freewater, Oregon

SE 1/4 SW 1/4 Sec. 27 T. 6 N. R. 35 E. W.M.

Bearing and distance from section or subdivision

corner 270' N. & 490' E. from SW cor. of SE 1/4 SW 1/4 of Section 27.

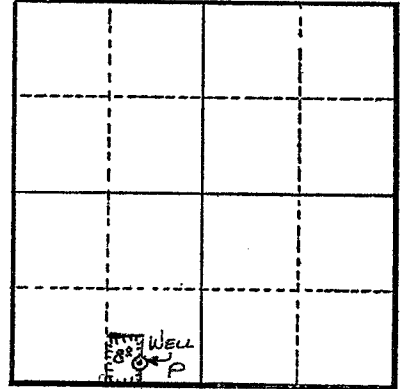

Section 27

Altitude at well 793 ft.

TYPE OF WELL: Dug&Drill Date Constructed Prior to 1914.

Depth drilled 135 ft. Depth cased 60 ft.

### CASING RECORD:

- 72 in. concrete curb from 0 to 27 ft.
- 8 in. steel casing from 40 to 60 ft.

### FINISH:

### AQUIFERS:

### WATER LEVEL:

41 ft.

PUMPING EQUIPMENT: Type Cook 4 1/2 in. turbine H.P.  
Capacity 100 G.P.M.

### WELL TESTS:

Drawdown 74 ft. after \_\_\_\_\_ hours 100 G.P.M.  
 Drawdown \_\_\_\_\_ ft. after \_\_\_\_\_ hours \_\_\_\_\_ G.P.M.

USE OF WATER Irrigation Temp. \_\_\_\_\_ °F. 19

SOURCE OF INFORMATION G. R. Record

DRILLER or DIGGER Overturf

### ADDITIONAL DATA:

Log N.A. Water Level Measurements \_\_\_\_\_ Chemical Analysis \_\_\_\_\_ Aquifer Test \_\_\_\_\_

### REMARKS:

Log not available

Irrigation of 8 acres.