

STATE ENGINEER  
Salem, Oregon

UMAT  
4746

# Well Record

STATE WELL NO. 6N/35-27R(1)  
COUNTY Umatilla  
APPLICATION NO. GR- 1179

GR- 1140

OWNER: Frank Derrick


MAILING ADDRESS: Rt. 3, Box 201

LOCATION OF WELL: Owner's No.

CITY AND STATE: Milton-Freewater, Oregon

SE 1/4 SE 1/4 Sec. 27 T. 6 N. R. 35 E. W.M.

Bearing and distance from section or subdivision corner 50' W. & 30' N. from SE cor. Sec. 27.

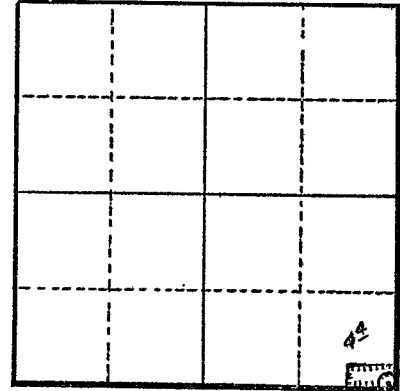

Section 27

Altitude at well 1000 ft.

TYPE OF WELL: Dug Date Constructed 1910

Depth drilled 40 ft. Depth cased 14 ft.

### CASING RECORD:

6 x 8 ft. concrete from 0 to 14 ft.

### FINISH:

### AQUIFERS:

### WATER LEVEL:

25 ft.

PUMPING EQUIPMENT: Type 2 1/2 in. Cent. H.P. 5  
Capacity 150 G.P.M.

### WELL TESTS:

Drawdown \_\_\_\_\_ ft. after \_\_\_\_\_ hours \_\_\_\_\_ G.P.M.  
Drawdown \_\_\_\_\_ ft. after \_\_\_\_\_ hours \_\_\_\_\_ G.P.M.

USE OF WATER Irrigation Temp. \_\_\_\_\_ °F. \_\_\_\_\_, 19

SOURCE OF INFORMATION G. R. Record

DRILLER or DIGGER

### ADDITIONAL DATA:

Log \_\_\_\_\_ Water Level Measurements \_\_\_\_\_ Chemical Analysis \_\_\_\_\_ Aquifer Test \_\_\_\_\_

### REMARKS:

Log: Top soil 0 to 2 ft.  
Cement gravel 2 to bottom.

Irrigation of 4.4 acres.