

STATE ENGINEER
Salem, Oregon

UMAT
4747

Well Record

STATE WELL NO. 6N/35-27R
COUNTY UMATILLA
APPLICATION NO. GR-2645

OWNER: Jack L. Wilson


MAILING ADDRESS: Rt. 3, Box 295

LOCATION OF WELL: Owner's No. _____

CITY AND STATE: Milton-Freewater, Oregon

SE 1/4 SE 1/4 Sec. 27 T. 6 N. S, R. 35 E. W, W.M.

Bearing and distance from section or subdivision corner 1019' N. and 200' W.

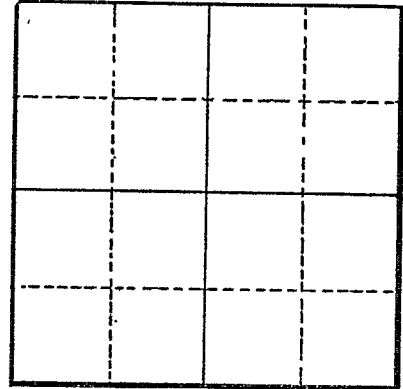

Section _____

Altitude at well _____

TYPE OF WELL Dug & Drilled Date Constructed 1910

Depth drilled 44 & 32 Depth cased 67

CASING RECORD:

5' x 5'
8-inch

FINISH:

AQUIFERS:

WATER LEVEL:

38-feet

PUMPING EQUIPMENT: Type Fairbanks Morse H.P. 3
Capacity 200 G.P.M.

WELL TESTS:

Drawdown _____ ft. after _____ hours _____ G.P.M.
Drawdown _____ ft. after _____ hours _____ G.P.M.

USE OF WATER Irrigation Temp. _____ °F. _____, 19____

SOURCE OF INFORMATION GR-2507

DRILLER or DIGGER _____

ADDITIONAL DATA:

Log _____ Water Level Measurements _____ Chemical Analysis _____ Aquifer Test _____

REMARKS: