

STATE ENGINEER  
Salem, Oregon

UMAT  
4749

# Well Record

STATE WELL NO. 6N/35-27M  
COUNTY Umatilla  
APPLICATION NO. GR-1531

OWNER: Alfred E. & Mary E. Scheuch

MAILING ADDRESS: \_\_\_\_\_

LOCATION OF WELL: Owner's No. \_\_\_\_\_

CITY AND STATE: \_\_\_\_\_

Milton-Freewater, Oregon

NW 1/4 SW 1/4 Sec. 27 T. 6 N. 35 W., W.M.


Bearing and distance from section or subdivision

corner \_\_\_\_\_

Altitude at well \_\_\_\_\_

TYPE OF WELL: Drilled Date Constructed 1910

Depth drilled 112 Depth cased 112

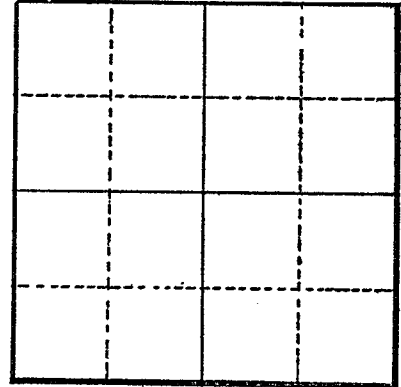

Section 27

### CASING RECORD:

- 6-8" from 0 to 16 feet
- " from 16 to 31 feet
- " " from 31 to 56 feet
- " from 56 to 112 feet

### FINISH:

### AQUIFERS:

### WATER LEVEL:

18 feet

PUMPING EQUIPMENT: Type Berkely centrifugal H.P. 5  
Capacity 650 G.P.M.

### WELL TESTS:

Drawdown \_\_\_\_\_ ft. after \_\_\_\_\_ hours \_\_\_\_\_ G.P.M.

Drawdown \_\_\_\_\_ ft. after \_\_\_\_\_ hours \_\_\_\_\_ G.P.M.

USE OF WATER Irrigation Temp. \_\_\_\_\_ °F., 19 \_\_\_\_\_

SOURCE OF INFORMATION GR-1531

DRILLER or DIGGER J. H. Overtuff (deceased)

### ADDITIONAL DATA:

Log \_\_\_\_\_ Water Level Measurements \_\_\_\_\_ Chemical Analysis \_\_\_\_\_ Aquifer Test \_\_\_\_\_

### REMARKS: