

STATE ENGINEER
Salem, Oregon

UMAT
4751

Well Record


STATE WELL NO. 6N/35-270
COUNTY UMATILLA
~~APPLICATION NO. GR-2560~~

OWNER: Chris Feigner & Carrie Feigner MAILING ADDRESS: RFD 2, Box 346

LOCATION OF WELL: Owner's No. CITY AND STATE: Milton-Freewater, Oregon

SW 1/4 SE 1/4 Sec. 27 T. 6 S, R. 35 E, W.M.

Bearing and distance from section or subdivision corner 80' N. & 25' W.

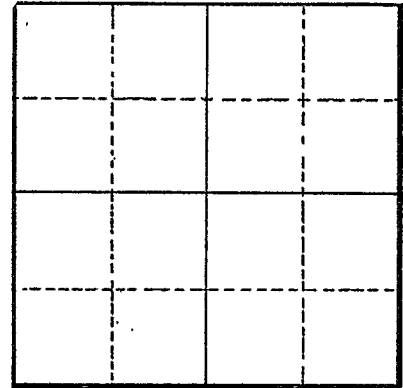

Section

Altitude at well

TYPE OF WELL: Dug, Drilled Date Constructed 1908

Depth drilled 120 Depth cased 15

CASING RECORD:

8-inch
60-inch

FINISH:

AQUIFERS:

Rock

WATER LEVEL:

30-feet

PUMPING EQUIPMENT: Type Peerless Turbine H.P. 7 1/2
Capacity 450 G.P.M.

WELL TESTS:

Drawdown 6 ft. after hours Pumping 450 G.P.M.
Drawdown ft. after hours G.P.M.

USE OF WATER Irrigation Temp. °F., 19

SOURCE OF INFORMATION GR-2418

DRILLER or DIGGER

ADDITIONAL DATA:

Log Water Level Measurements Chemical Analysis Aquifer Test

REMARKS:

Concrete Rock 6 1/2 50
Water course 4 54
Concrete 66 120