

STATE ENGINEER
Salem, Oregon

UMAT
4752

Well Record


STATE WELL NO. 6N/35-270
COUNTY UMATILLA
APPLICATION NO. GR-2561

OWNER: Chris Feigner & Carrie Feigner Mailing ADDRESS: FED. 2, Box 346

LOCATION OF WELL: Owner's No. #2 CITY AND STATE: Milton-Freewater, Oregon

SW 1/4 SE 1/4 Sec. 27 T. 6 N. S, R. 35 E. W.M.

Bearing and distance from section or subdivision corner W. 570' & N. 35'

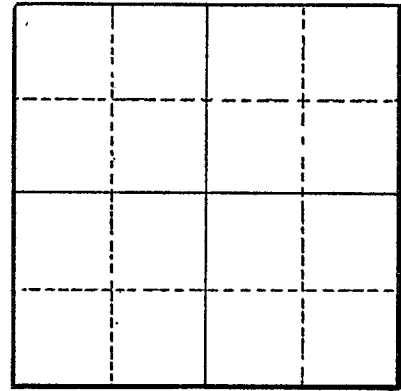

Section

Altitude at well

TYPE OF WELL Dug, Drilled Date Constructed 1902

Depth drilled 480 Depth cased 60

CASING RECORD:

8-inch
60-inch

FINISH:

AQUIFERS:

Rock, clay

WATER LEVEL:

30-feet

PUMPING EQUIPMENT: Type Five Inch, Centrifugal H.P. 7
Capacity 400 G.P.M.

WELL TESTS:

Drawdown 5 ft. after hours Pumping 400 G.P.M.
Drawdown ft. after hours G.P.M.

USE OF WATER Irrigation Temp. °F., 19

SOURCE OF INFORMATION GR-2419

DRILLER or DIGGER

ADDITIONAL DATA:

Log Water Level Measurements Chemical Analysis Aquifer Test

REMARKS:

Concrete rock	265	315
Reddish clay	7	322
Concrete rock gray	28	350
Concrete rock red	30	380
Red clay	10	390
Gray clay	30	420
Gray-blue clay	60	480