

STATE ENGINEER
Salem, Oregon

UMAT
4753

Well Record

STATE WELL NO. 6N/35-27H
COUNTY Umatilla
APPLICATION NO. GB-1631

GR- 1596

OWNER: J.E., Ernest & Norman Kessler

MAILING ADDRESS: Rt. 3, Box 55


LOCATION OF WELL: Owner's No.

CITY AND STATE: Milton-Freewater, Oregon

SE 1/4 NE 1/4 Sec. 27 T. 6 N. R. 35 E. W.M.

Bearing and distance from section or subdivision

corner 50' W. from E 1/4 cor. Sec. 27

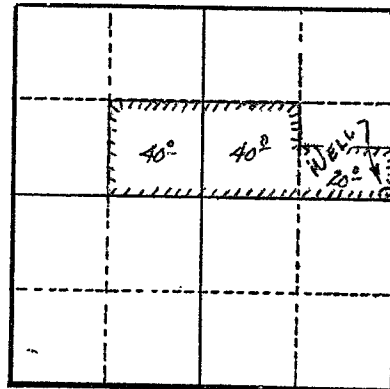

Section 27

Altitude at well 995'

TYPE OF WELL: Dug & Drilled Date Constructed 1899

Depth drilled 100' Depth cased ?

CASING RECORD:

Dug - 5' x 5' from 0 to 30 ft.

Drilled - 6"

FINISH:

AQUIFERS:

GRAVEL

WATER LEVEL:

15'

PUMPING EQUIPMENT: Type Jacuzzi Cent. H.P. 5
Capacity 500 G.P.M.

WELL TESTS:

Drawdown 24 ft. after 500 hours G.P.M.

Drawdown ft. after hours G.P.M.

USE OF WATER Irrigation Temp. °F. 19

SOURCE OF INFORMATION GB Record

DRILLER or DIGGER

ADDITIONAL DATA:

Log N.A. Water Level Measurements Chemical Analysis Aquifer Test

REMARKS: See log in U.S.G.S. Walla Walla Report by Newcomb (1951) Page 154
Irrigation of 100 acres.