

UMAT
4755


Well Record

OWNER: E. A. Knopf
MAILING ADDRESS:

LOCATION OF WELL: Owner's No. CITY AND STATE:

..... 1/4 1/4 Sec. T. N. E. S, R. W., W.M.

Bearing and distance from section or subdivision corner

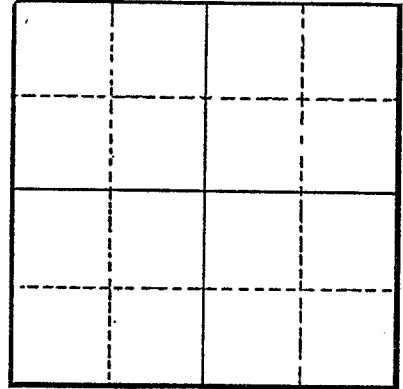

Section

Altitude at well 845

TYPE OF WELL: Dg. & dr. Date Constructed

Depth drilled 220 Depth cased

CASING RECORD:

60-8 inch

FINISH:

AQUIFERS:

Gravel

WATER LEVEL:

PUMPING EQUIPMENT: Type Centrifugal H.P.
Capacity 300 G.P.M.

WELL TESTS:

Drawdown ft. after hours G.P.M.
Drawdown ft. after hours G.P.M.

USE OF WATER Irrigation Temp. °F., 19.

SOURCE OF INFORMATION USGS

DRILLER or DIGGER

ADDITIONAL DATA:

Log Water Level Measurements Chemical Analysis Aquifer Test

REMARKS:

Hardness (calcium carbonate) 45 p.p.m.
Chloride 6 p.p.m.