

NOTICE TO WATER WELL CONTRACTOR
The original and first copy of this report are to be filed with the

WATER WELL REPORT
UMAT 4763

RECEIVED
MAY 12 1978

State Well No. 60N/3E-28da

STATE ENGINEER, SALEM, OREGON 97310
within 30 days from the date of well completion.

STATE OF OREGON
(Please type or print)
(Do not write above this line)

WATER RESOURCES DEPT.
SALEM, OREGON
State Permit No.

UMAT
4763

(1) OWNER: and (Guarantea)
Name Jack D. Susanenko
Address Mt. 2 Box 355
Milton-Freewater, Ore.

(2) TYPE OF WORK (check):
New Well Deepening Reconditioning Abandon
If abandonment, describe material and procedure in Item 12.

(3) TYPE OF WELL:
Rotary Driven
Cable Jetted
Dug Bored

(4) PROPOSED USE (check):
Domestic Industrial Municipal
Irrigation Test Well Other

(5) CASING INSTALLED:
Threaded Welded
" Diam. from 0 ft. to 106-9" ft. Gage 350
" Diam. from _____ ft. to _____ ft. Gage _____
" Diam. from _____ ft. to _____ ft. Gage _____

(6) PERFORATIONS:
Type of perforator used Machine Acetylene
Size of perforations 1/4 x 8 in. by 8 in.
_____ perforations from _____ ft. to _____ ft.
120 perforations from 40 ft. to 98 ft.
_____ perforations from _____ ft. to _____ ft.

(7) SCREENS:
Well screen installed? Yes No
Manufacturer's Name _____
Type _____ Model No. _____
Diam. _____ Slot size _____ Set from _____ ft. to _____ ft.
Diam. _____ Slot size _____ Set from _____ ft. to _____ ft.

(8) WELL TESTS:
Drawdown is amount water level is lowered below static level
Was a pump test made? Yes No If yes, by whom? L. Marshall
Yield: 500 gal./min. with 70 ft. drawdown after 5 hrs.
" " " " " "
" " " " " "
Bailer test _____ gal./min. with _____ ft. drawdown after _____ hrs.
Artesian flow _____ g.p.m.
Temperature of water 58 Depth artesian flow encountered _____ ft.

(9) CONSTRUCTION:
Well seal—Material used Bentonite
Well sealed from land surface to 20 ft.
Diameter of well bore to bottom of seal 10 in.
Diameter of well bore below seal 8 in.
Number of sacks of cement used in well seal _____ sacks
Number of sacks of bentonite used in well seal 2 sacks
Brand name of bentonite National
Number of pounds of bentonite per 100 gallons of water 80 lbs./100 gals.
Was a drive shoe used? Yes No Plugs _____ Size: location _____ ft.
Did any strata contain unusable water? Yes No
Type of water? _____ depth of strata _____
Method of sealing strata off _____
Was well gravel packed? Yes No Size of gravel: _____
Gravel placed from _____ ft. to _____ ft.

(10) LOCATION OF WELL:
County UMATI Driller's well number _____
Bearing and distance from section or subdivision corner
Well located 15 ft. W 759 ft. S of property NE corner.

(11) WATER LEVEL: Completed well.
Depth at which water was first found 35 ft.
Static level 23 ft. below land surface. Date April 22-78
Artesian pressure _____ lbs. per square inch. Date _____

(12) WELL LOG: Diameter of well below casing 8
Depth drilled 123 ft. Depth of completed well 110 ft.
Formation: Describe color, texture, grain size and structure of materials; and show thickness and nature of each stratum and aquifer penetrated, with at least one entry for each change of formation. Report each change in position of Static Water Level and indicate principal water-bearing strata.

MATERIAL	From	To	SWL
Top soil + clay	0	5	
Cement gravel (Brown)	5	35	
Drilling water		35	
Gravel cemented - Brown	35	72	
Gravel Med. coarse water bearing	72	87	23
Gravel with some Brown clay	87	123	

Work started April 10 1978 Completed April 22 1978
Date well drilling machine moved off of well April 23 1978

Drilling Machine Operator's Certification:
This well was constructed under my direct supervision. Materials used and information reported above are true to my best knowledge and belief.
[Signed] Lowell Marshall Date April 28 1978
(Drilling Machine Operator)
Drilling Machine Operator's License No. 11

Water Well Contractor's Certification:
This well was drilled under my jurisdiction and this report is true to the best of my knowledge and belief.
Name Lowell W. Marshall
(Person, firm or corporation) (Type or print)
Address MT 2 Box 140-B M. F. Ore.
[Signed] Lowell W. Marshall
(Water Well Contractor)
Contractor's License No. 265 Date April 28 1978

UMAT 4763

316
1202
3.11 Ac.

1201
2.00 Ac

318
1100
3.76 Ac.

320
502
2.57 Ac.

415
504
2.37 Ac.

158
900
1.88 Ac.

11
800
3.13 Ac.

165
801
2.72 Ac.

600
2.72 Ac.

700
2.76 Ac.


1/4 Cor.

842.12'

759 ft

15 ft from
centerline

See Map 6N 35 27C

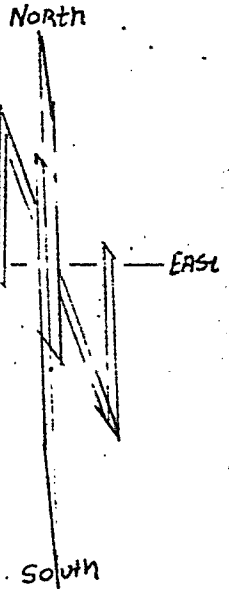

*Jack & Juanita
Shaw*

2200
28.55 Ac.

N 81° 25' 25" E 445.92'

TRACT II
2500
1.31 Ac.

2400
9.85 Ac.

S 2 N 2 SE SE

2300
16.53 Ac.

S 2 SE SE

2301
2.57 Ac.

28

27

NO. 456

33

34

See Map 6N 35 33A

6N 35 28

TRACT I:

Beginning at the Northwest corner of the Northeast Quarter of the Southeast Quarter of Section 28, Township 6 North, Range 35, said corner being the Northwest corner of that tract of land described in Book 309, Page 288, Deed Records, said corner also being the true point of beginning for this description; thence North 89° 35' 35" East along the North line of said Northeast Quarter of the Southeast Quarter of said Section 28, a distance of 496.08 feet; thence South 00° 05' 35" East a distance of 1,669.75 feet to a point on the South line of the North Half of the North Half of the Southeast Quarter of the Southeast Quarter of said Section 28; thence South 89° 51' 15" West along said South line a distance of 496.06 feet to a point on the West line of the Southeast Quarter of the Southeast Quarter of said Section 28; thence North 00° 05' 35" West a distance of 1,666.20 feet to the point of beginning;

All being East of the Willamette Meridian, Umatilla County, Oregon.

EXCEPTING any and all water rights of way and roads.

TRACT II:

Beginning at the Northwest corner of the Northeast Quarter of the Southeast Quarter of Section 28, Township 6 North, Range 35, said corner being the Northwest corner of that tract of land described in Book 309, Page 288, Deed Records; thence North 89° 35' 35" East along the North line of said Section 28, a distance of 496.08 feet; thence South 00° 05' 35" East a distance of 1,669.75 feet to a point on the South line of the North Half of the North Half of the Southeast Quarter of the Southeast Quarter of said Section 28, said point also being the true point of beginning for this description; thence North 89° 51' 15" East a distance of 445.92 feet; thence North 00° 13' 25" East a distance of 150 feet; thence South 89° 51' 15" West a distance of 445.92 feet, more or less, to the East line of the hereinabove mentioned tract I; thence South 00° 05' 35" East along said East line a distance of 150 feet, more or less, to the point of beginning;

TOGETHER with a non-exclusive easement over and across the North Half of the North Half of the Southeast Quarter of the Southeast Quarter of said Section 28 and being described as follows, to-wit:

Beginning at a point on the West line of County Road No. 597, said point also being West 20 feet and North 150 feet from the Southeast corner of the North Half of the North Half of the Southeast Quarter of the Southeast Quarter of said Section 28; thence South 89° 51' 15" West a distance of 405 feet; thence North 00° 13' 25" East a distance of 25 feet; thence North 89° 51' 15" East a distance of 405 feet to a point on the Westerly line of said County Road No. 597; thence South along said West line of County Road a distance of 25 feet to the point of beginning;

All being East of the Willamette Meridian, Umatilla County, Oregon;

EXCEPTING any and all water rights of way and roads.

UMAT 4763
For Official Use Only:

Received Date:

County Well Log ID #

Well Identification Tag #

UMAT 4763

23333

WELL IDENTIFICATION APPLICATION FORM

RECEIVED

FEB 19 1998

BUYER/CURRENT WELL OWNER:

WATER RESOURCES DEPT.
SALEM, OREGON

Name: B Edward J Waliser

Mailing Address: 53446 Hwy 332

City: Milton-Freewater State: OR Zip: 97862 Phone: (541) 938-4637

WELL LOCATION:

County: Umatilla Owner's Well Number: 4763

Township: 6 (N) or S, Range: 35 (E) or W, Section: 28 NE 1/4 SE 1/4

Tax Lot Number: 2601 Type of Well: water supply monitoring

Street Address of Well (if different from above): same as above

WELL INFORMATION: (do not complete remainder of application if well log is available)

Start Card Number: _____ Approx. Construction Date: April 1978

Well Constructor: Marlatt

Name of Owner at Time of Construction: Jack D Slusarenko

Well Depth (in feet): 123 Static Water Level (in feet): 23 feet

Diameter of Exposed Well Casing (in inches): 8 inches

Does this well have a formal water right associated with it? Yes: No:

If Yes: Application #: _____ Permit #: 610441 Certificate #: _____

Please Return Completed Form to:

Lisa Juul
Well Identification Program
Oregon Water Resources Department
158 12th Street NE
Salem, OR 97310