

STATE ENGINEER
Salem, Oregon

UMAT
4785

Well Record

GR- 1106

STATE WELL NO. 6N/35-34(1)
COUNTY Umatilla
APPLICATION NO. GR- 1146

OWNER: W. J. Miller


MAILING ADDRESS: Rt. 2, Box 12

LOCATION OF WELL: Owner's No.

CITY AND STATE: Milton-Freewater, Oregon

NE 1/4 SE 1/4 Sec. 34 T. 6 N. R. 35 E. 8, W.M.

Bearing and distance from section or subdivision corner 1' N. & 20' W. of SE cor. of NE 1/4 SE 1/4 of Section 34.

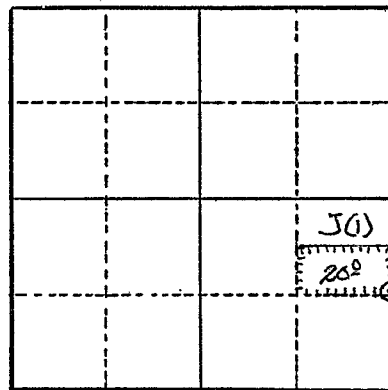

Section 34

Altitude at well 950 ft.

TYPE OF WELL: Dug&drilled Date Constructed 1908

Depth drilled 100 ft. Depth cased 5 ft.

CASING RECORD:

Dug section from 0 to 48 ft. (not cased) 72 inch.
Drilled & cased with 8 in. from 48 to 53 ft.
Drilled but not cased from 53 to 100 ft.

FINISH:

AQUIFERS:

WATER LEVEL:

20 ft.

PUMPING EQUIPMENT: Type 4" turbine & 2 1/2" x 2 1/2" cent. booster H.P. Both 5
Capacity 300 G.P.M.

WELL TESTS:

Drawdown ft. after hours G.P.M.
Drawdown ft. after hours G.P.M.

USE OF WATER Irrigation Temp. °F., 19

SOURCE OF INFORMATION G. R. Record

DRILLER or DIGGER

ADDITIONAL DATA:

Log Water Level Measurements Chemical Analysis Aquifer Test

REMARKS:

Log: Surface soil 0 to 2 ft.
Cemented gravel & rock 2 to 100 ft.

Irrigation of 20 acres