

STATE ENGINEER
Salem, Oregon

Well Record

STATE WELL NO. 6N/35-28J
COUNTY Umatilla
APPLICATION NO. GR-1670

UMAT
4791

GR- 1621

OWNER: Cecil E. Stanton

MAILING

ADDRESS: Rt. 3, Box 33

LOCATION OF WELL: Owner's No.


CITY AND

STATE: Milton-Freewater, Oregon

NE 1/4 SE 1/4 Sec. 28 T. 6 S., R. 35 W., W.M.

Bearing and distance from section or subdivision

corner 1310' S. & 10' W. from E 1/4 cor. Sec. 28

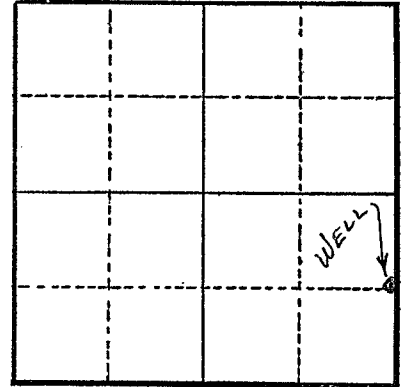

Section 28

Altitude at well 900'

TYPE OF WELL: Dug & Drill'd Date Constructed 1922

Depth drilled 50' Depth cased 48'

CASING RECORD:

8" from 10 to 48 ft.

FINISH:

Perforated with 3/8" cuts, 10 per ft., from 30 to 45 ft.

AQUIFERS:

WATER LEVEL:

15 - 20 ft.

PUMPING EQUIPMENT: Type 2" x 2 1/2" Cent. H.P. 3
Capacity 175? G.P.M.

WELL TESTS:

Drawdown _____ ft. after _____ hours _____ G.P.M.

Drawdown _____ ft. after _____ hours _____ G.P.M.

USE OF WATER Irrigation Temp. _____ °F., 19

SOURCE OF INFORMATION GR Record

DRILLER or DIGGER

ADDITIONAL DATA:

Log _____ Water Level Measurements _____ Chemical Analysis _____ Aquifer Test _____

REMARKS:

Log: Top soil 0 to 4 ft.
Gravel & cement gravel 4 to 50 ft.

Irrigation of 40 acres.