

STATE ENGINEER  
Salem, Oregon

UMAT  
4793

# Well Record

STATE WELL NO. 6N/35-28  
COUNTY UMATILLA  
APPLICATION NO. GR-2478

OWNER: Mildred Moretz


MAILING ADDRESS: 418 Washington St.

LOCATION OF WELL: Owner's No. \_\_\_\_\_

CITY AND STATE: Dayton, Washington

S  $\frac{1}{2}$  of N  $\frac{1}{2}$  of SE  $\frac{1}{4}$  SE  $\frac{1}{4}$  Sec. 28 T. 6 N. S, R. 35 E. W.M.

Bearing and distance from section or subdivision corner 310' W. and 50' N.

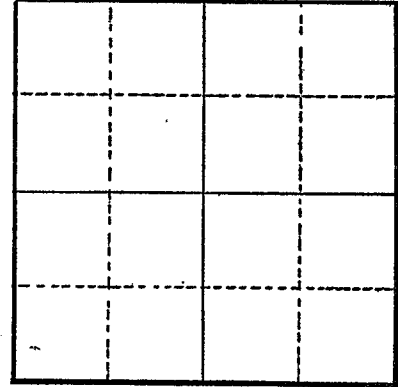

Section \_\_\_\_\_

Altitude at well \_\_\_\_\_

TYPE OF WELL Dug, Drilled Date Constructed 1918

Depth drilled 82 Depth cased 82

### CASING RECORD:

60" x 66"  
36"  
10"

### FINISH:

### AQUIFERS:

### WATER LEVEL:

22-feet

PUMPING EQUIPMENT: Type Fairbanks Morse H.P. 3  
Capacity 150 G.P.M.

### WELL TESTS:

Drawdown 52 ft. after \_\_\_\_\_ hours Pumping 150 G.P.M.  
Drawdown \_\_\_\_\_ ft. after \_\_\_\_\_ hours \_\_\_\_\_ G.P.M.

USE OF WATER Irrigation Temp. \_\_\_\_\_ °F., 19 \_\_\_\_\_

SOURCE OF INFORMATION GR-2347

DRILLER or DIGGER \_\_\_\_\_

### ADDITIONAL DATA:

Log \_\_\_\_\_ Water Level Measurements \_\_\_\_\_ Chemical Analysis \_\_\_\_\_ Aquifer Test \_\_\_\_\_

### REMARKS: