

STATE ENGINEER
Salem, Oregon

UMAT
4794

Well Record

STATE WELL NO. 6N/35-28R(2)
COUNTY Umatilla
APPLICATION NO. GR-1140

GR- 1100

OWNER: John M. & Abbie H. Hanson


MAILING ADDRESS: Rt. 2, Box 320

LOCATION OF WELL: Owner's No.

CITY AND STATE: Milton-Freewater, Oregon

SE 1/4 SE 1/4 Sec. 28 T. 6 S, R. 35 W, W.M.

Bearing and distance from section or subdivision
corner 61' W. & 244' N. from SE cor. of Sec. 28.

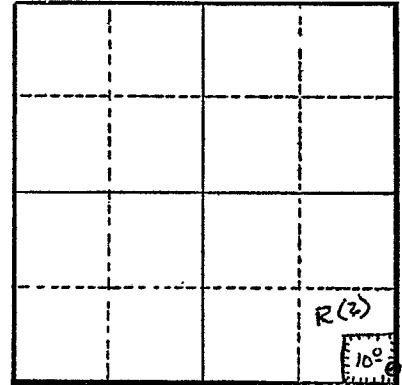

Section 28

Altitude at well

TYPE OF WELL: Dug & dr'd Date Constructed 1916

Depth drilled 90 ft. Depth cased 50 ft.

CASING RECORD:

72" x 72" cement curbing from 0 to 26 ft.
8 inch steel casing from 30 to 50 ft.

FINISH:

AQUIFERS:

WATER LEVEL:

7 ft.

PUMPING EQUIPMENT: Type 2 1/2" Berkeley Cent. H.P. 5
Capacity 200 G.P.M.

WELL TESTS:

Drawdown 41 ft. after hours 200 G.P.M.
Drawdown ft. after hours G.P.M.

USE OF WATER Irrigation Temp. °F., 19

SOURCE OF INFORMATION G. R. Record

DRILLER or DIGGER

ADDITIONAL DATA:

Log Water Level Measurements Chemical Analysis Aquifer Test

REMARKS:

Log: Top soil & rocks 0 to 1 1/2 ft.
Cement gravel 1 1/2 to 90 ft.

Irrigation of 10 acres.