

STATE ENGINEER  
Salem, Oregon

UMAT  
4806

# Well Record

STATE WELL NO. <sup>6N</sup> 35-29F(1)  
COUNTY UMATILLA  
APPLICATION NO. U 790

OWNER: Ray Northrup

MAILING ADDRESS: R2, Box 306


LOCATION OF WELL: Owner's No. \_\_\_\_\_

CITY AND STATE: Milton, Fess. water

SE 1/4 NW 1/4 Sec. 29 T. 6 N. S, R. 75 E. W.M.

Bearing and distance from section or subdivision

corner 680 ft S. & 1 ft E. of  
N.E. corner S.W. 1/4 N.W. 1/4, Sec 29

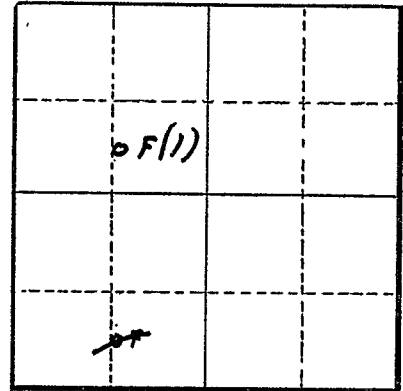

Section 29

Altitude at well \_\_\_\_\_

TYPE OF WELL: Drilled Date Constructed Feb-March 1954

Depth drilled 109 Depth cased 26 to 35 feet

### CASING RECORD:

8-inch, set from 26 to 35 feet

### FINISH:

open hol. below casing

### AQUIFERS:

Gravel

### WATER LEVEL:

20 feet below land surface

### PUMPING EQUIPMENT: Type \_\_\_\_\_

H.P. 7 1/2

Capacity \_\_\_\_\_ G.P.M.

### WELL TESTS:

Drawdown 77 ft. after 2 hours pumping 140 G.P.M.

Drawdown 50 ft. after \_\_\_\_\_ hours pumping 125 G.P.M.

USE OF WATER Irrigation

Temp. \_\_\_\_\_ °F., 19 \_\_\_\_\_

SOURCE OF INFORMATION well Driller Report

DRILLER or DIGGER Earl G. Shattidge

### ADDITIONAL DATA:

Log  Water Level Measurements \_\_\_\_\_ Chemical Analysis \_\_\_\_\_ Aquifer Test \_\_\_\_\_

### REMARKS:

