

UMAT
4813

Well Record

OWNER: W. C. Mason


MAILING ADDRESS: Route 3, Box 275

LOCATION OF WELL: Owner's No. _____

CITY AND STATE: Milton-Freewater, Oregon

SE $\frac{1}{4}$ NW $\frac{1}{4}$ Sec. 29 T. 6 N. X, R. 35 W, W.M.

Bearing and distance from section or subdivision
corner 547 ft. S. from apt. 19 ft. W. from NE
corner of SE $\frac{1}{4}$ NW $\frac{1}{4}$ Sec. 29

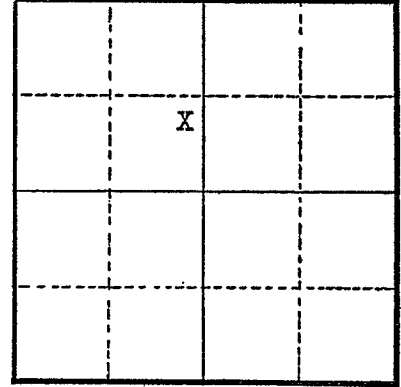

Section 29

Altitude at well _____

TYPE OF WELL: Drilled Date Constructed 2/1/22

Depth drilled 73 ft. Depth cased 59 ft.

CASING RECORD:

8 inch casing set from 49 ft. to 59 ft.

FINISH:

None

AQUIFERS:

WATER LEVEL:

20 to 40 feet below surface

PUMPING EQUIPMENT: Type Sterling centrifugal H.P. 3
Capacity 225 G.P.M.

WELL TESTS:

Drawdown 45 ft. after _____ hours 220 G.P.M.
Drawdown _____ ft. after _____ hours _____ G.P.M.

USE OF WATER Irrigation Temp. _____ °F., 19 _____

SOURCE OF INFORMATION Well Registration Statement

DRILLER or DIGGER _____

ADDITIONAL DATA:

Log X Water Level Measurements _____ Chemical Analysis _____ Aquifer Test _____

REMARKS:

Log: Dug part 6 ft. top soil and gravel, 4' of sand and gravel, rest cement stratas and loose gravel to 27 ft. then cement gravel stratas to 49 ft. drill hole thru gravel to 73 ft. depth of well.