

STATE ENGINEER
Salem, Oregon

UMAT
4814

Well Record

STATE WELL NO. 6N/35-29A
COUNTY Umatilla
APPLICATION NO. GR-1498

GR- 1448

OWNER: Alvin V. Edwards

MAILING
ADDRESS:

LOCATION OF WELL: Owner's No.


CITY AND
STATE:

Milton-Freewater, Oregon

NE 1/4 NE 1/4 Sec. 29 T. 6 N. 35 E. W.M.

Bearing and distance from section or subdivision

corner 675' W. & 1284' S. from NE cor. Sec. 29

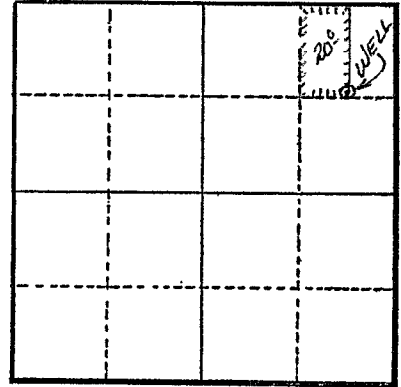

Section 29

Altitude at well 700'

TYPE OF WELL: Dug Date Constructed 1921

Depth drilled 30' Depth cased 20'

CASING RECORD:

6' x 6' concrete from 0 to 20 ft.

FINISH:

AQUIFERS:

WATER LEVEL:

18'

PUMPING EQUIPMENT: Type Westinghouse 2" H.P. 5
Capacity 160 G.P.M.

WELL TESTS:

Drawdown ft. after hours G.P.M.

Drawdown ft. after hours G.P.M.

USE OF WATER Irrigation Temp. °F. 19

SOURCE OF INFORMATION GR Record

DRILLER or DIGGER

ADDITIONAL DATA:

Log N.A. Water Level Measurements Chemical Analysis Aquifer Test

REMARKS:

Irrigation of 20 acres