

STATE ENGINEER  
Salem, Oregon

UMAT  
4815

# Well Record

GR- 1121

STATE WELL NO. 6N/35-29B(1)  
COUNTY Umatilla  
APPLICATION NO. GR- 1157

OWNER: C. E. Eyler

MAILING  
ADDRESS:

LOCATION OF WELL: Owner's No.


CITY AND  
STATE:

Milton Firewater, Oregon

NW 1/4 NE 1/4 Sec. 29 T. 6 N. R. 35 E. W.M.

Bearing and distance from section or subdivision

corner 5' N. & 18' W. of SE cor. NW 1/4 NE 1/4 of Sec. 29.

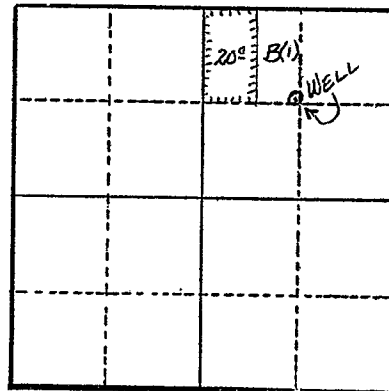

Section 29

Altitude at well 825 ft.

TYPE OF WELL: Dug Date Constructed 1919

Depth drilled 28 ft. Depth cased 11 ft.

## CASING RECORD:

5 x 5 ft. concrete curb from 0 to 11 ft.

FINISH:

## AQUIFERS:

Gravel

## WATER LEVEL:

13 ft. (March)

PUMPING EQUIPMENT: Type 2 in. Westinghouse  
Capacity 250 G.P.M.

H.P. 5

## WELL TESTS:

Drawdown 10 ft. after 250 hours G.P.M.

Drawdown ft. after hours G.P.M.

USE OF WATER Irrigation Temp. °F. 19

SOURCE OF INFORMATION G. R. Record

DRILLER or DIGGER

## ADDITIONAL DATA:

Log Water Level Measurements Chemical Analysis Aquifer Test

## REMARKS:

Log: Gravel & sand  
Cement gravel

0 to 11 ft.  
11 to 28 ft.

Irrigation of 20 acres.

Drill hole in well to 8 ft. yielded no additional water.