

STATE ENGINEER
Salem, Oregon

UMAT
4816

Well Record

STATE WELL NO. 6N/35-29J
COUNTY Umatilla
APPLICATION NO. GR-1243

GR- 1201

OWNER: Roy E. and/or Artimescia Edwards

MAILING ADDRESS: Box 97


LOCATION OF WELL: Owner's No.

CITY AND STATE: Milton-Freewater, Oregon

NE ¼ SE ¼ Sec. 29 T. 6 N. R. 35 E. W.M.

Bearing and distance from section or subdivision

corner 134.5' N. & 40' W. from SE cor. Sec. 29.

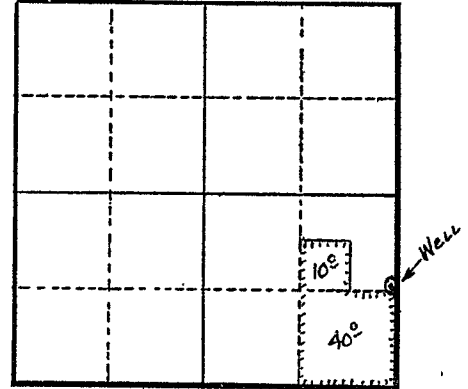

Section 29

Altitude at well 900 ft.

TYPE OF WELL: Dug Date Constructed 1917

Depth drilled 32 ft. Depth cased 10 ft.

CASING RECORD:

60 x 60 in. concrete curb from 0 to 10 ft.

FINISH:

AQUIFERS:

WATER LEVEL:

10 ft.

PUMPING EQUIPMENT: Type 3 x 4 in. Cent. H.P. 10
Capacity 416 G.P.M.

WELL TESTS:

Drawdown 18 ft. after hours 416 G.P.M.

Drawdown ft. after hours G.P.M.

USE OF WATER Irrigation Temp. °F. 19

SOURCE OF INFORMATION G. R. Record

DRILLER or DIGGER

ADDITIONAL DATA:

Log Water Level Measurements Chemical Analysis Aquifer Test

REMARKS:

Log: Top soil 0 to 8 ft.
Loose gravel 8 to 15 ft.
Concrete gravel 15 to 30 ft.

Irrigation of 50 acres.