

STATE ENGINEER  
Salem, Oregon

UMAT  
4817

# Well Record

STATE WELL NO. 6N/35-29K(1)  
COUNTY Umatilla  
APPLICATION NO. GR-1130

GR- 1090

OWNER: Edward A. Knopf

MAILING ADDRESS: Rt. 3, Box 63


LOCATION OF WELL: Owner's No.

CITY AND STATE: Milton-Freewater, Oregon

NW 1/4 SE 1/4 Sec. 29 T. 6 N. R. 35 E., W.M.

Bearing and distance from section or subdivision

corner 326' S. & 25' W. from NE cor. of NW 1/4 SE 1/4 of Section 29.

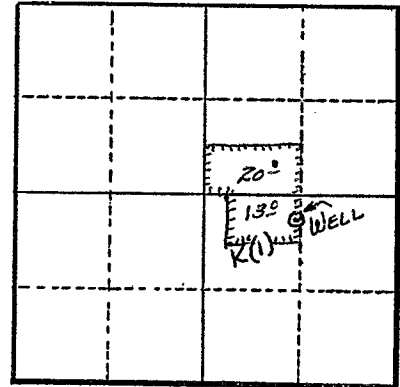

Section 29

Altitude at well 900 ft.

TYPE OF WELL: Dug & Drilled Date Constructed 1916

Depth drilled 153 ft. Depth cased 20 ft.

### CASING RECORD:

10 inch from 38 to 58 ft.

### FINISH:

Perforated

### AQUIFERS:

### WATER LEVEL:

17 ft.

PUMPING EQUIPMENT: Type Pomona turbine

H.P. 10

Capacity G.P.M.

(5 HP Booster)

### WELL TESTS:

Drawdown 63 ft. after 300 hours G.P.M.

Drawdown ft. after hours G.P.M.

USE OF WATER Irrigation Temp. °F. 19

SOURCE OF INFORMATION G. R. Record

DRILLER or DIGGER

### ADDITIONAL DATA:

Log N.A. Water Level Measurements Chemical Analysis Aquifer Test

### REMARKS:

Irrigation of 33 acres.