

STATE ENGINEER
Salem, Oregon

UMAT
4844

Well Record

STATE WELL NO. 6N/35-30F
COUNTY Umatilla
APPLICATION NO. GR-3931

OWNER: Katie Leinbach

MAILING

ADDRESS: Route 2, Box 75


CITY AND

STATE: Milton-Freewater, Oregon

LOCATION OF WELL: Owner's No.

SE 1/4 NW 1/4 Sec. 30 T. 6 N. E. S. R. 35 W., W.M.

Bearing and distance from section or subdivision
corner 370' W. & 30' N. of center of Sec. 30

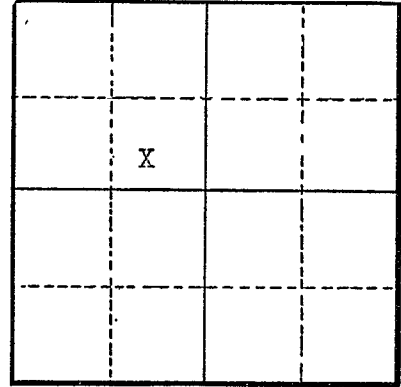

Section 30

Altitude at well

TYPE OF WELL: Dug Date Constructed 1922

Depth drilled 25 ft. Depth cased 12 ft.

CASING RECORD:

72 inches cement from 0 to 12 feet

FINISH:

AQUIFERS:

WATER LEVEL:

15 feet below surface

PUMPING EQUIPMENT: Type Fairbanks Morse H.P. 10
Capacity 200 G.P.M.

WELL TESTS:

Drawdown ft. after hours G.P.M.

Drawdown ft. after hours G.P.M.

USE OF WATER Irrigation Temp. °F. 19

SOURCE OF INFORMATION Well Registration Statement Cert. # GR-3565

DRILLER or DIGGER Henry Rouse

ADDITIONAL DATA:

Log Water Level Measurements Chemical Analysis Aquifer Test

REMARKS: