

(1) OWNER:
Name GEORGE IVOR REES WILLIAMS
Address Box 126 Route #1
WALLA WALLA WASH.

UMAT
4864

(2) LOCATION OF WELL:
County UMATILLA Owner's number, if any—
R. F. D. or Street No. UMAPINE
Bearing and distance from section or subdivision corner
1294 feet from SW corner of the heartland
of the N.W. quarter of
Sec 32 Twp 6 N R 35

(3) TYPE OF WORK (check):
w well Deepening Reconditioning Abandon
If abandonment, describe material and procedure in Item 11.

(4) PROPOSED USE (check):
Domestic Industrial Municipal
Irrigation Test Well Other

(5) EQUIPMENT:
Rotary
Cable
Dug Well

(6) CASING INSTALLED:
Threaded Welded

FROM	ft. to	ft.	Diam.	Gage or wall	Diameter of Bore	from ft.	to ft.
"0"	"520"	"10"	"10"	"14"	"	"	"
"515"	"635"	"8"	"8"	"14"	"	"	"
"	"	"	"	"	"	"	"
"	"	"	"	"	"	"	"

If gravel packed
Size of gravel:
Type and size of shoe or well ring Standard
Describe joint

(7) PERFORATIONS:
Type of perforator used None

DEPTH of perforations	ft.	in., length, by	in.
FROM	ft. to	perf per foot	No. of rows
"	"	"	"
"	"	"	"
"	"	"	"
"	"	"	"

SCREENS:
Give Manufacturer's Name, Model No. and Size

(8) CONSTRUCTION:
Was a surface sanitary seal provided? Yes No To what depth ft.
Were any strata sealed against pollution? Yes No
If yes, note depth of strata
FROM 0 ft. to 100 ft.

METHOD OF SEALING Bedding mud around pipe

(9) WATER LEVELS:
Depth at which water was first found 80 ft.
Standing level before perforating _____ ft.
Standing level 182 ft.
Log Accepted by: _____

[Signed] _____ Dated _____, 19____
Owner

Was a pump test made? Yes No If yes, by whom? DRILLER.
Yield: gal./min. with _____ ft. draw down after _____ hrs.
"500" "28" "8"
Artesian flow _____ g.p.m.
Shut-in pressure _____ lbs. per square inch.
Bailer test _____ g.p.m. with _____ ft. drawdown
Temperature of water _____ Was a chemical analysis made? Yes No
Was electric log made of well? Yes No

(11) WELL LOG:
Diameter of well 10 inches.
Total depth 715 ft. Depth of completed well 715 ft.

Formation: Describe by color, character, size of material and structure, and show thickness of aquifers and the kind and nature of the material in each stratum penetrated, with at least one entry for each change of formation.

ft. to	ft.	
0"	32"	TOP SOIL
32"	185"	Gravel & CLAY
185"	189"	CAVING GRAVEL
189"	225"	Gravel & CLAY
225"	503"	GRAY CLAY
503"	520"	Brown CLAY & Broken Rock
520"	530"	BLACK BASALT
530"	550"	BROKEN BASALT (BLACK)
550"	588"	BLACK BASALT
588"	635"	CAVING BLACK BASALT
635"	640"	BLACK BASALT
640"	650"	CAVING BLACK BASALT
640"	650"	CEMENTED
650"	697"	BLACK BASALT
697"	715"	CAVING BLACK BASALT
697"	715"	WATER BEDDING

62
W
1-20

Ground elevation at well site 925 feet above mean sea level.
Work started DEC. 20 1954 Completed NOV 12 1955

Well Driller's Statement:
This well was drilled under my jurisdiction and this report is true to the best of my knowledge and belief.
NAME HEITSTUMAN BROS.
(Person, firm, or corporation) (Typed or printed)
Address MILTON-FREEWATER, OREG.
Driller's well number _____
[Signed] Albert J. Heitstuman
(Well Driller)
License No. 146 Dated DEC. 5, 1955

STATE ENGINEER
Salem, Oregon

UMAT
4864


Well Record

STATE WELL NO. ^{6N/35-32E(1)}
COUNTY UMATILLA
APPLICATION NO. _____

OWNER: George Williams MAILING ADDRESS: Rt 1, Box 126
LOCATION OF WELL: Owner's No. _____ CITY AND STATE: Walla Walla, Wash

SW 1/4 NW 1/4 Sec. 32 T. 6 ^{N.} 8, R. 35 ^{E.} W., W.M.

Bearing and distance from section or subdivision corner _____

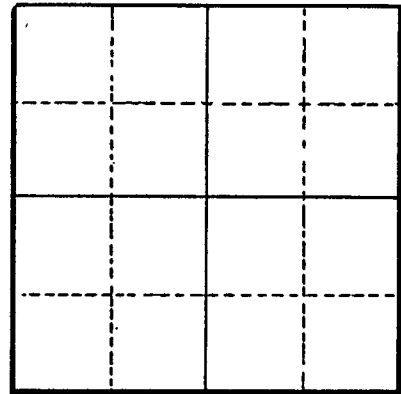

Section 32

Altitude at well _____

TYPE OF WELL: Drilled Date Constructed Dec 54 - Nov 55

Depth drilled 715 Depth cased 635

CASING RECORD:

10-inch, set from 0 to 520 feet
8-inch, set from 515 to 635 feet

FINISH:

Open hole below casing

AQUIFERS:

Basalt

WATER LEVEL:

142 feet below land surface, November 1955

PUMPING EQUIPMENT: Type _____ H.P. _____
Capacity _____ G.P.M.

WELL TESTS:

Drawdown 28 ft. after 8 hours pumping 500 G.P.M.
Drawdown _____ ft. after _____ hours _____ G.P.M.

USE OF WATER Irrigation Temp. _____ °F. _____, 19____

SOURCE OF INFORMATION Well Drillers Report
DRILLER or DIGGER Heitstuman Bros.

ADDITIONAL DATA:

Log Water Level Measurements _____ Chemical Analysis _____ Aquifer Test _____

REMARKS:

