

STATE ENGINEER  
Salem, Oregon



# Well Record

STATE WELL NO. 6N/35-34G  
COUNTY Umatilla  
APPLICATION NO. GR-1483

GR- 1516

OWNER: Leonard F. Lorenzen


MAILING ADDRESS: 110 NE Furnish

LOCATION OF WELL: Owner's No.

CITY AND STATE: Pendleton, Oregon

SW 1/4 NE 1/4 Sec. 34 T. 6 N. R. 35 E. W.M.

Bearing and distance from section or subdivision corner 375' S. of NE cor. of SW 1/4 of Sec. 34

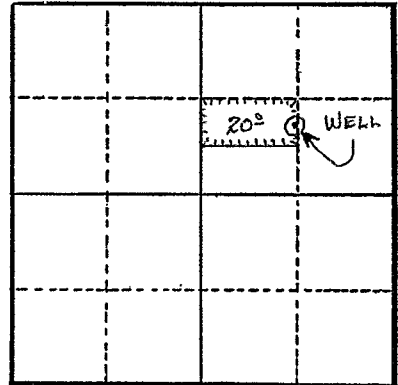

Section 34

Altitude at well 900'

TYPE OF WELL: Dug & Drilled Date Constructed 1908

Depth drilled 100' Depth cased 60'

### CASING RECORD:

- 6' x 6' concrete from 0 to 15 ft. (Dug)
- 12" steel from 15 to 60 ft. (Drilled)

### FINISH:

### AQUIFERS:

### WATER LEVEL:

42' as of Dec. '57

PUMPING EQUIPMENT: Type Cook 5" turbine H.P. 7 1/2  
Capacity 400 G.P.M.

### WELL TESTS:

Drawdown ..... ft. after ..... hours ..... G.P.M.

Drawdown ..... ft. after ..... hours ..... G.P.M.

USE OF WATER Irrigation & Domestic Temp. °F., 19

SOURCE OF INFORMATION GR Record

DRILLER or DIGGER

### ADDITIONAL DATA:

Log Water Level Measurements Chemical Analysis Aquifer Test

### REMARKS:

Estimated log:

Top soil	0 to 2 ft.
Gravel	2 to 44 ft.
Cement gravel	44 to 52 ft.
Clay	52 to 72 ft.
Concrete gravel	72 to 94 ft.

Irrigation of 20 acres.