

STATE ENGINEER  
Salem, Oregon

UMAT  
4898

# Well Record

STATE WELL NO. 6N/35-33M  
COUNTY Umatilla  
APPLICATION NO. GR-3483

OWNER: Harry Phillips


MAILING ADDRESS: Route 2, Box 65

LOCATION OF WELL: Owner's No. Well #2

CITY AND STATE: Milton-Freewater, Oregon

NW 1/4 SW 1/4 Sec. 33 T. 6 N. S. R. 35 E. W., W.M.

Bearing and distance from section or subdivision corner 660' S. 37' W.

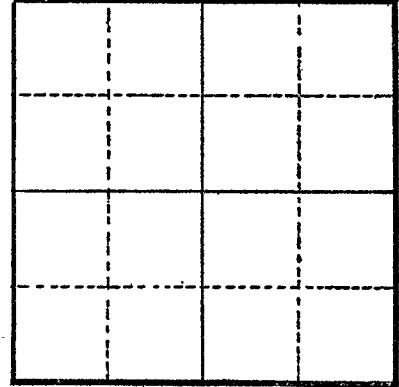

Section

Altitude at well

TYPE OF WELL: drilled & dug Date Constructed 1916

Depth drilled 90' Depth cased 40'

### CASING RECORD:

60 x 72"  
10"

### FINISH:

### AQUIFERS:

topsoil, cement gravel

### WATER LEVEL:

35'

PUMPING EQUIPMENT: Type 5" turbine H.P. 5  
Capacity 300 G.P.M.

### WELL TESTS:

Drawdown 30 ft. after hours pumping 300 G.P.M.  
Drawdown ft. after hours G.P.M.

USE OF WATER Irrigation Temp. °F., 19

SOURCE OF INFORMATION GR-3217

DRILLER or DIGGER Overturf (deceased)

### ADDITIONAL DATA:

Log  Water Level Measurements Chemical Analysis Aquifer Test

### REMARKS:

topsoil 3 3  
cement gravel 87 90