

STATE ENGINEER  
Salem, Oregon

UMAT  
4499

# Well Record

STATE WELL NO. 6N/35-33J(1)  
COUNTY UMATILLA  
APPLICATION NO. \_\_\_\_\_

OWNER: J. NELSON MAILING ADDRESS: \_\_\_\_\_

LOCATION OF WELL: Owner's No. \_\_\_\_\_ CITY AND STATE: \_\_\_\_\_


NE 1/4 SE 1/4 Sec. 33 T. 6 N. 3, R. 35 W., W.M.

Bearing and distance from section or subdivision corner \_\_\_\_\_

Altitude at well 875'

TYPE OF WELL: D.R. Date Constructed 1933?

Depth drilled 442' Depth cased \_\_\_\_\_

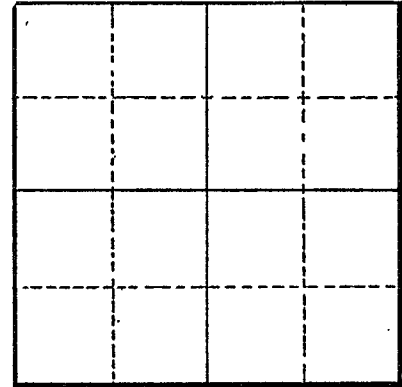

Section 33

### CASING RECORD:

8 INCH

### FINISH:

### AQUIFERS:

BASALT (from 415 to 442)

### WATER LEVEL:

15.12 - JUNE 10, 1933

PUMPING EQUIPMENT: Type TURBINE H.P. \_\_\_\_\_  
Capacity 200 G.P.M.

### WELL TESTS:

Drawdown \_\_\_\_\_ ft. after \_\_\_\_\_ hours \_\_\_\_\_ G.P.M.  
Drawdown \_\_\_\_\_ ft. after \_\_\_\_\_ hours \_\_\_\_\_ G.P.M.

USE OF WATER IRR. Temp. \_\_\_\_\_ °F. \_\_\_\_\_, 19\_\_\_\_

SOURCE OF INFORMATION U.S.G.S.

DRILLER or DIGGER HAIG BEAS.

### ADDITIONAL DATA:

Log X Water Level Measurements \_\_\_\_\_ Chemical Analysis \_\_\_\_\_ Aquifer Test \_\_\_\_\_

REMARKS: See U.S.G.S. Walla Walla Report by Newcomb (1951) Page 155