

STATE ENGINEER  
Salem, Oregon

UMAT  
4900

# Well Record


STATE WELL NO. 6N/35-33A  
COUNTY Umatilla  
APPLICATION NO. GR-3860

OWNER: Archie Harris MAILING ADDRESS: \_\_\_\_\_

LOCATION OF WELL: Owner's No. \_\_\_\_\_ CITY AND STATE: Milton-Freewater, Oregon

NE 1/4 NE 1/4 Sec. 33 T. 6 N. R. 35 E. W.M.

Bearing and distance from section or subdivision corner 1305' S. & 155' W. from NE Cor. Sec. 33

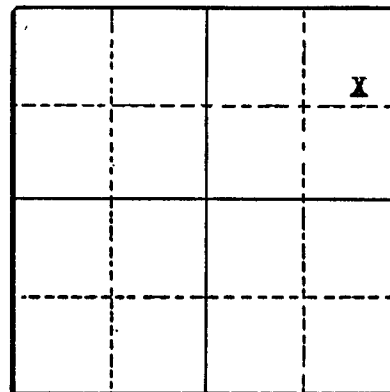

Section 33

Altitude at well \_\_\_\_\_

TYPE OF WELL: Drilled <sup>Dug 52'</sup> <sub>50'</sub> Date Constructed 1920

Depth drilled 102 ft. Depth cased 102 ft.

### CASING RECORD:

4 inch casing set from 52 to 102 feet

### FINISH:

### AQUIFERS:

### WATER LEVEL:

20-40 feet below surface

PUMPING EQUIPMENT: Type Johnson H.P. 7 1/2  
Capacity 190 G.P.M.

### WELL TESTS:

Drawdown \_\_\_\_\_ ft. after \_\_\_\_\_ hours \_\_\_\_\_ G.P.M.  
Drawdown \_\_\_\_\_ ft. after \_\_\_\_\_ hours \_\_\_\_\_ G.P.M.

USE OF WATER Irrigation Temp. \_\_\_\_\_ °F. \_\_\_\_\_, 19\_\_\_\_

SOURCE OF INFORMATION Well Registration Statement Cert. # GR-3632

DRILLER or DIGGER \_\_\_\_\_

### ADDITIONAL DATA:

Log \_\_\_\_\_ Water Level Measurements \_\_\_\_\_ Chemical Analysis \_\_\_\_\_ Aquifer Test \_\_\_\_\_

### REMARKS: