

STATE ENGINEER
Salem, Oregon

UMAT
4901

Well Record

STATE WELL NO. 6N/35-33Q
COUNTY Umatilla
APPLICATION NO. GR-3017

OWNER: Ray and Gloc V. Kelly


MAILING ADDRESS: Route 2, Box 37

LOCATION OF WELL: Owner's No.

CITY AND STATE: Milton-Freewater, Oregon

SW 1/4 SE 1/4 Sec. 33 T. 6 N. S., R. 35 E. W., W.M.

Bearing and distance from section or subdivision corner 2620' (including angles) NW of Section Corner common to 3, 4, 33 and 34.

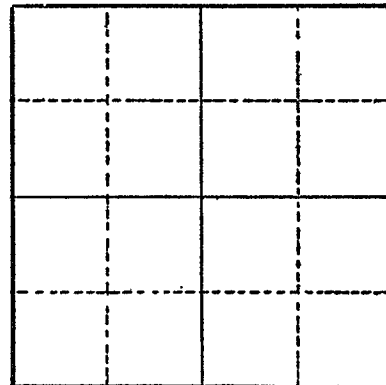

Section

Altitude at well

TYPE OF WELL: dug Date Constructed prior to 1927

Depth drilled 63' Depth cased

CASING RECORD:

5' x 5' concrete curb

FINISH:

AQUIFERS:

WATER LEVEL:

20'

PUMPING EQUIPMENT: Type Centrifugal H.P. 5
Capacity 160 G.P.M.

WELL TESTS:

Drawdown 10 ft. after hours pumping 160 G.P.M.
Drawdown ft. after hours G.P.M.

USE OF WATER Irrigation Temp. °F., 19

SOURCE OF INFORMATION GR-2824

DRILLER or DIGGER

ADDITIONAL DATA:

Log Water Level Measurements Chemical Analysis Aquifer Test

REMARKS: