

STATE ENGINEER
Salem, Oregon

UMAT
4903

Well Record

STATE WELL NO. 6N/35-33C
COUNTY Umatilla
APPLICATION NO. GR-1184


GR- 1145

OWNER: Lloyd Bookout
MAILING ADDRESS: Rt. 1, Box 313

LOCATION OF WELL: Owner's No. CITY AND STATE: Milton-Freewater, Oregon

NE 1/4 NW 1/4 Sec. 33 T. 6 N. R. 35 E. W.M.

Bearing and distance from section or subdivision
corner 100' W. & 100' N. from SE cor. of NE 1/4
of Section 33.

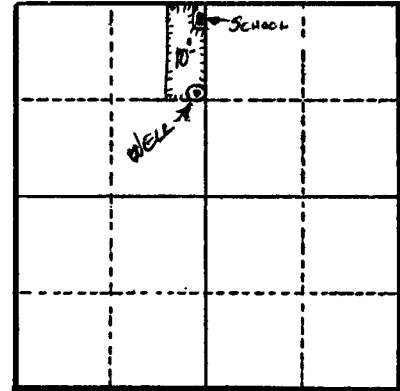

Section 33

Altitude at well 750 ft.

TYPE OF WELL: Drilled Date Constructed 1926

Depth drilled 75 ft. Depth cased 30 ft.

CASING RECORD:

8 in. from 0 to 30 ft.

FINISH:

AQUIFERS:

WATER LEVEL:

25 ft.

PUMPING EQUIPMENT: Type 4 in. F. M. turbine H.P. 5
Capacity 300 G.P.M.

WELL TESTS:

Drawdown None ft. after hours 300 G.P.M.

Drawdown ft. after hours G.P.M.

USE OF WATER Irrigation Temp. °F. 19

SOURCE OF INFORMATION G. R. Record

DRILLER or DIGGER W. E. Jones

ADDITIONAL DATA:

Log Water Level Measurements Chemical Analysis Aquifer Test

REMARKS:

Log: Top soil 0 to 10 ft.
Gravel 10 to 75 ft.

Irrigation of 10 acres.