

STATE ENGINEER
Salem, Oregon

UMAT
4905

Well Record

STATE WELL NO. 6N/35-33B
COUNTY Umatilla
APPLICATION NO. GR-4229

OWNER: Wm. J. & Carolyn K. Jackson


MAILING ADDRESS: Route 2, Box 318

LOCATION OF WELL: Owner's No. _____

CITY AND STATE: Milton-Freewater, Oregon

NW 1/4 NE 1/4 Sec. 33 T. 6 N. R. 35 E. W.M.

Bearing and distance from section or subdivision corner 1310' S. & 10' W. from NE Cor. NW 1/4 NE 1/4

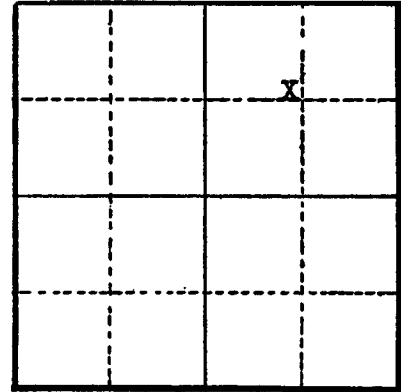

Section 33

Altitude at well _____

TYPE OF WELL: Drill ^{Dug 42'} 72' Date Constructed 1924

Depth drilled 70 ft. Depth cased 57 ft.

CASING RECORD:

6' x 6' concrete from 0 to 15 feet
8 in. steel casing from 42 to 57 feet

FINISH:

AQUIFERS:

WATER LEVEL:

20 feet below surface, down to 45 feet

PUMPING EQUIPMENT: Type Peerless turbine H.P. 5
Capacity 250 G.P.M.

WELL TESTS:

Drawdown _____ ft. after _____ hours _____ G.P.M.
Drawdown _____ ft. after _____ hours _____ G.P.M.

USE OF WATER Irrigation Temp. _____ °F. _____, 19____

SOURCE OF INFORMATION Well Registration Statement Cert. # GR-3768

DRILLER or DIGGER _____

ADDITIONAL DATA:

Log _____ Water Level Measurements _____ Chemical Analysis _____ Aquifer Test _____

REMARKS: