

STATE ENGINEER
Salem, Oregon

UMAT
4906

Well Record

STATE WELL NO. 6N/35-33E(1)
COUNTY Umatilla
APPLICATION NO. GR-1094

GR- 1055

OWNER: C. O. Wheeler


MAILING ADDRESS: Rt. 2, Box 61

LOCATION OF WELL: Owner's No.

CITY AND STATE: Milton-Freswater, Oregon

SW 1/4 NW 1/4 Sec. 33 T. 6 N. 0, R. 33 E., W.M.

Bearing and distance from section or subdivision corner 15' N. & 480' E. of the NW cor. Sec. 33.

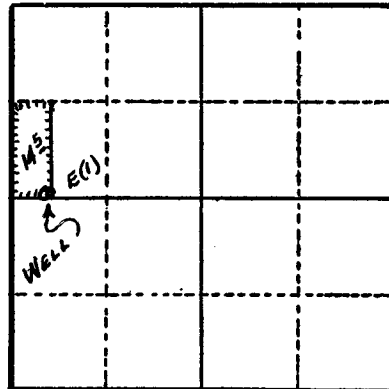

Section 33

Altitude at well

TYPE OF WELL: Dug & Drill Date Constructed 1922

Depth drilled 50 ft. Depth cased 20 ft.

CASING RECORD:

72 in. from 0 to 30 ft.
6 in. from 30 to 50 ft.

FINISH:

AQUIFERS:

WATER LEVEL:

6 ft.

PUMPING EQUIPMENT: Type Cook 5 in. turbine H.P. 3
Capacity 300 G.P.M.

WELL TESTS:

Drawdown ft. after hours G.P.M.
Drawdown ft. after hours G.P.M.

USE OF WATER Irrigation Temp. °F., 19....

SOURCE OF INFORMATION G.R. Record

DRILLER or DIGGER

ADDITIONAL DATA:

Log Water Level Measurements Chemical Analysis Aquifer Test

REMARKS:

Log: Fine sandy top soil 0 to 3 ft.
Cement gravel 3 to 50 ft.

Irrigation of 14.5 acres.