

STATE ENGINEER
Salem, Oregon

UMAT
4907

Well Record

STATE WELL NO. 6N/35-33D(1)
COUNTY Umatilla
APPLICATION NO. GR-1234

GR- 1193

OWNER: Reta Crow MAILING ADDRESS: Rt. 2, Box 63A

LOCATION OF WELL: Owner's No. CITY AND STATE: Milton-Freewater, Oregon


NW 1/4 NW 1/4 Sec. 33 T. 6 N. R. 35 E., W.M.

Bearing and distance from section or subdivision
corner 40' W. & 320' N. from SE cor. of NW 1/4 NW 1/4
of Section 33.

Altitude at well 800 ft.

TYPE OF WELL: Dug Date Constructed Prior to 1920

Depth drilled 40 ft. Depth cased 10 ft.

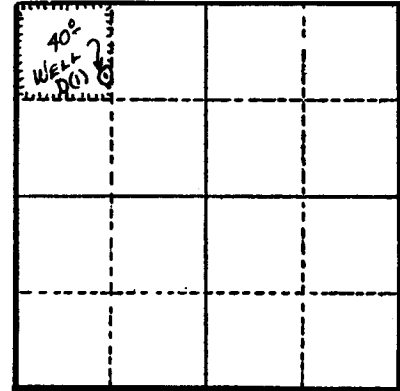

Section 33

CASING RECORD:

6 x 6 ft. cement curb from 0 to 10 ft.

FINISH:

AQUIFERS:

WATER LEVEL:

20 ft.

PUMPING EQUIPMENT: Type F. M. 2 in. pressure pump H.P. 10
Capacity 250 G.P.M.

WELL TESTS:

Drawdown 10 ft. after hours 250 G.P.M.

Drawdown ft. after hours G.P.M.

USE OF WATER Irrigation Temp. °F. 19

SOURCE OF INFORMATION G. R. Record

DRILLER or DIGGER

ADDITIONAL DATA:

Log Water Level Measurements Chemical Analysis Aquifer Test

REMARKS:

Log: Top soil 0 to 10 ft.
Gravel 10 to 40 ft.

Irrigation of 40 acres.