

STATE ENGINEER
Salem, Oregon

UMAT
4909

Well Record

STATE WELL NO. 6N/35-331(2)
COUNTY Umatilla
APPLICATION NO. GR-1128

GR- 1088

OWNER: Virgil Carter


MAILING ADDRESS: Rt. 3, Box 21

LOCATION OF WELL: Owner's No.

CITY AND STATE: Milton-Freewater, Oregon

NE 1/4 SW 1/4 Sec. 33 T. 6 N. R. 35 E., W.M.

Bearing and distance from section or subdivision corner 920' S. & 1010' W. from Center of Sec. 33.

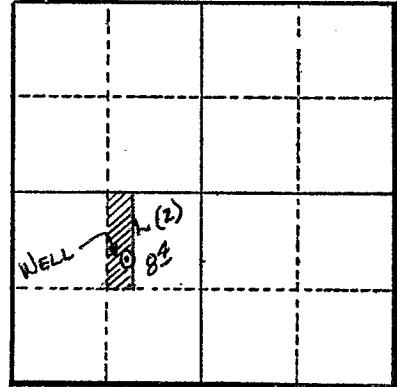

Section 33

Altitude at well 925 ft.

TYPE OF WELL: Dug & Drilled Date Constructed 1919

Depth drilled 125 ft. Depth cased 125 ft.

CASING RECORD:

- 6 x 6 ft. dug hole from 0 to 53 ft.
- 10 inch regular casing from 53 to 83 ft.
- Open drilling from 83 to 125 ft.

FINISH:

AQUIFERS:

WATER LEVEL:

50 ft.

PUMPING EQUIPMENT: Type Peerless turbine H.P. 3
Capacity G.P.M.

WELL TESTS:

Drawdown ft. after hours G.P.M.
 Drawdown ft. after hours G.P.M.

USE OF WATER Irrigation Temp. °F. 19

SOURCE OF INFORMATION G. R. Record

DRILLER or DIGGER

ADDITIONAL DATA:

Log N.A. Water Level Measurements Chemical Analysis Aquifer Test

REMARKS:

Irrigation of 8.4 acres.