

STATE ENGINEER  
Salem, Oregon

UMAT  
4910

# Well Record

STATE WELL NO. 6N/35-33E  
COUNTY Umatilla  
APPLICATION NO. GR-1323

GR- 1278

OWNER: Bert Pesciallo


MAILING ADDRESS: Rt. 2, Box 59

LOCATION OF WELL: Owner's No.

CITY AND STATE: Milton-Freewater, Oregon

SE 1/4 NW 1/4 Sec. 33 T. 6 N. S. R. 35 W., W.M.

Bearing and distance from section or subdivision corner 25' N. & 50' W. from the Center of the SE 1/4 NW 1/4 of Section 33.

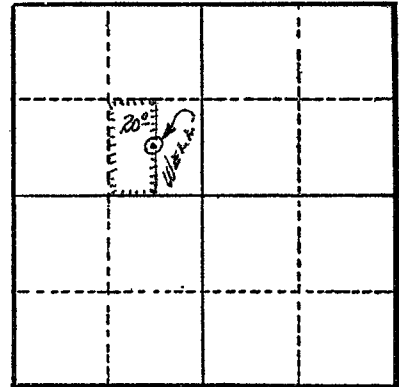

Section 33

Altitude at well 823 ft.

TYPE OF WELL: Dug & Drilled Date Constructed 1919

Depth drilled 120 ft. Depth cased 120 ft.

### CASING RECORD:

6 x 6 ft. concrete curb from 0 to 16 ft.  
8 in. steel casing from 50 to 120 ft.

### FINISH:

### AQUIFERS:

GRAVEL

### WATER LEVEL:

30 ft.

PUMPING EQUIPMENT: Type ~~Electric~~ F.M. 4 IN. H.P. 7 1/2

Capacity 500 G.P.M.

### WELL TESTS:

Drawdown ft. after hours G.P.M.

Drawdown ft. after hours G.P.M.

USE OF WATER Irrigation Temp. °F. 19

SOURCE OF INFORMATION G. R. Record

DRILLER or DIGGER

### ADDITIONAL DATA:

Log N.A. Water Level Measurements Chemical Analysis Aquifer Test

### REMARKS:

Irrigation of 20 acres.