

STATE ENGINEER
Salem, Oregon



Well Record

STATE WELL NO. 6N/35-33M
COUNTY Umatilla
APPLICATION NO. GR-3482

OWNER: Harry Phillips


MAILING ADDRESS: Route 2, Box 65

LOCATION OF WELL: Owner's No. _____

CITY AND STATE: Milton-Freewater, Oregon

NW 1/4 SW 1/4 Sec. 33 T. 6 N. S. R. 35 E. W. W.M.

Bearing and distance from section or subdivision corner 946' S. 37' W.

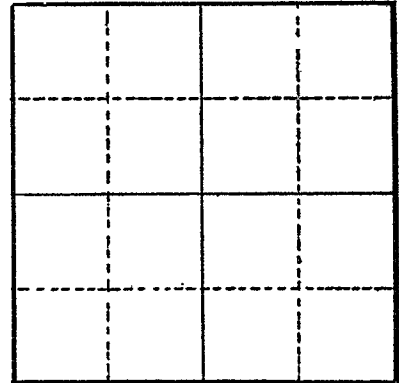

Section _____

Altitude at well _____

TYPE OF WELL: drilled Date Constructed 1916

Depth drilled 140' Depth cased 55'

CASING RECORD:

72 x 60"
8"

FINISH:

AQUIFERS:

topsoil gravelly
concrete gravel

WATER LEVEL:

PUMPING EQUIPMENT: Type 4" Cent. H.P. 5
Capacity 300 G.P.M.

WELL TESTS:

Drawdown _____ ft. after _____ hours _____ G.P.M.
Drawdown _____ ft. after _____ hours _____ G.P.M.

USE OF WATER Irrigation Temp. _____ °F. _____, 19_____

SOURCE OF INFORMATION GR-3216

DRILLER or DIGGER _____

ADDITIONAL DATA:

Log Water Level Measurements _____ Chemical Analysis _____ Aquifer Test _____

REMARKS:

topsoil gravelly 3 3
concrete gravel 137 140