

STATE ENGINEER
Salem, Oregon

UMAT
4914

Well Record

STATE WELL NO. 6N/35-33R(1)
COUNTY Umatilla
APPLICATION NO. GR-1144

GR- 1104

OWNER: R. G. Prudhomme


MAILING ADDRESS: Rt. 2, Box 226

LOCATION OF WELL: Owner's No.

CITY AND STATE: Milton-Freewater, Oregon

SE 1/4 SE 1/4 Sec. 33 T. 6 N. R. 35 E. W.M.

Bearing and distance from section or subdivision corner 523' N. & 40' W. from SE cor. Sec. 33.

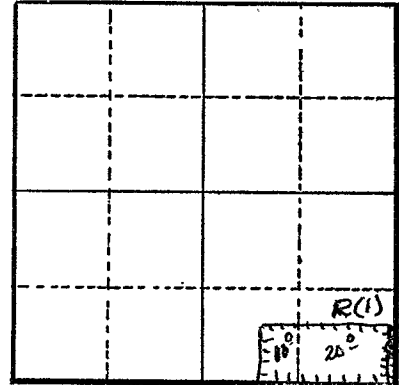

Section 33

Altitude at well 1005 ft.

TYPE OF WELL: Dug & Drilled Date Constructed 1915

Depth drilled 90 ft. Depth cased 40 ft.

CASING RECORD:

8' x 8' concrete curb from 0 to 18 ft.
12 in. steel from 12 to 40 ft.

FINISH:

AQUIFERS:

WATER LEVEL:

20 ft.

PUMPING EQUIPMENT: Type Pacific Unit type 2" H.P. 5
Capacity 350 G.P.M.

WELL TESTS:

Drawdown ft. after hours G.P.M.
Drawdown ft. after hours G.P.M.

USE OF WATER Irrigation Temp. °F. 19

SOURCE OF INFORMATION G. R. Record

DRILLER or DIGGER

ADDITIONAL DATA:

Log Water Level Measurements Chemical Analysis Aquifer Test

REMARKS:

Log: Top soil 0 to 2 ft.
Gravel & rock 2 to 30 ft.
No more information available.

Irrigation of 30 acres.