

STATE ENGINEER  
Salem, Oregon

UMAT  
4915

# Well Record

STATE WELL NO. 6N/35-33H  
COUNTY UMATILLA  
APPLICATION NO. GR-2519

OWNER: Guy Thompson


MAILING ADDRESS: Rt. 3, Box 25

LOCATION OF WELL: Owner's No.

CITY AND STATE: Milton-Freewater, Oregon

SE 1/4 NE 1/4 Sec. 33 T. 6 N. R. 35 E. W.M.

Bearing and distance from section or subdivision corner 854' N. & 24' W.

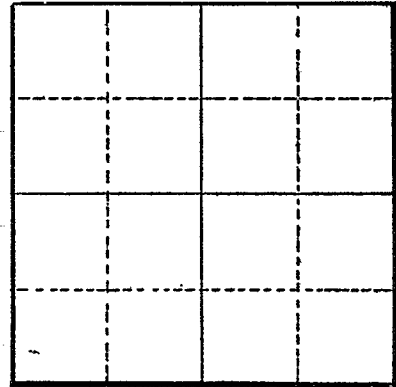

Section

Altitude at well

TYPE OF WELL: Dug, Drilled Date Constructed 1915

Depth drilled 65 Depth cased 55

CASING RECORD:

6-feet  
8-inch

FINISH:

AQUIFERS:

WATER LEVEL:

25 to 30 feet

PUMPING EQUIPMENT: Type Pamona Turbine H.P. 5  
Capacity 400 G.P.M.

WELL TESTS:

Drawdown ft. after hours G.P.M.  
Drawdown ft. after hours G.P.M.

USE OF WATER Irrigation Temp. °F. 19

SOURCE OF INFORMATION GR-2383

DRILLER or DIGGER

ADDITIONAL DATA:

Log Water Level Measurements Chemical Analysis Aquifer Test

REMARKS: