

STATE ENGINEER
Salem, Oregon

UMAT
4917

Well Record

GR- 1673

STATE WELL NO. 6N/35-33E
COUNTY Umatilla
APPLICATION NO. GR- 1724

OWNER: Mark Anthony Pesciallo


MAILING ADDRESS: Rt. 2, Box 58

LOCATION OF WELL: Owner's No.

CITY AND STATE: Milton-Freewater, Oregon

SE 1/4 NW 1/4 Sec. 33 T. 6 N. R. 35 E. W.M.

Bearing and distance from section or subdivision corner 40' N. & 20' W. of Center of Sec. 33

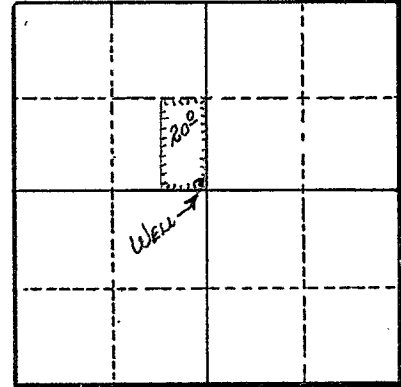

Section 33

Altitude at well 830'

TYPE OF WELL: Dug & Drilled Date Constructed 1910

Depth drilled 116' Depth cased 116'

CASING RECORD:

- 6' x 6' concrete curb from 0 to 15 ft.
- 8" steel casing from 46 to 116 ft.

FINISH:

AQUIFERS:

WATER LEVEL:

32'

PUMPING EQUIPMENT: Type Pacific 4" Cent. H.P. 7 1/2

Capacity 450 G.P.M.

WELL TESTS:

Drawdown ft. after hours G.P.M.

Drawdown ft. after hours G.P.M.

USE OF WATER Irrigation Temp. °F., 19

SOURCE OF INFORMATION GR Record

DRILLER or DIGGER

ADDITIONAL DATA:

Log Water Level Measurements Chemical Analysis Aquifer Test

REMARKS:

Log: Loose gravel 0 to 95 ft.
Cement gravel 95 to 116 ft.

Irrigation of 20 acres.